


Give All Information Completely
Make Required Affidavit
Mail or Deliver Report to:
Conservation Division
State Corporation Commission
212 No. Market
Wichita, Kansas

WELL PLUGGING RECORD

Harper County, Sec. 5 Twp. 34 Rge. 5 (E) W (W)

Location as "NE/CNW/SW" or footage from lines SW - NE
Lease Owner International Hydrocarbons, Inc.
Lease Name Equity Well No. 1
Office Address 4815 South Harvard, Suite 444, Tulsa, Oklahoma
Character of Well (completed as Oil, Gas or Dry Hole) oil well
Date well completed 10-4-69 19
Application for plugging filed 11-10-69 19
Application for plugging approved 11-13-69 19
Plugging commenced 11-19-69 19
Plugging completed 11-22-69 19
Reason for abandonment of well or producing formation Depleted

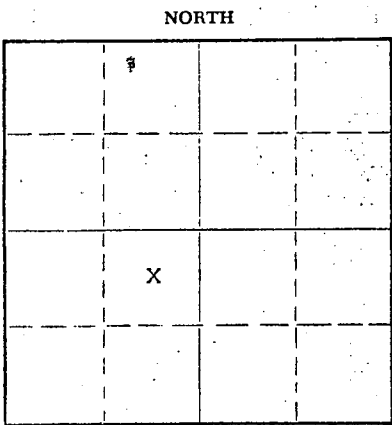

Locate well correctly on above Section Plat

If a producing well is abandoned, date of last production 19
Was permission obtained from the Conservation Division or its agents before plugging was commenced? yes

Name of Conservation Agent who supervised plugging of this well Herman Justin
Producing formation Depth to top Bottom Total Depth of Well 5009 Feet
Show depth and thickness of all water, oil and gas formations.

OIL, GAS OR WATER RECORDS

CASING RECORD

FORMATION	CONTENT	FROM	TO	SIZE	PUT IN	PULLED OUT
				8 5/8"	249'	none
				5 1/2"	4620'	35414.48

Describe in detail the manner in which the well was plugged, indicating where the mud fluid was placed and the method or methods used in introducing it into the hole. If cement or other plugs were used, state the character of same and depth placed, from feet to feet for each plug set.
P.B.T.D. 3840', filled with gravel from 3840' to 3770', mixed and dumped 5 sacks of cement.
Set a 10' rock bridge from 240' to 230', dumped 25 sacks of cement, mud hole to 130', dumped 15 sacks of cement to surface.

RECEIVED
STATE CORPORATION COMMISSION
DEC 8 1969
CONSERVATION DIVISION
Wichita, Kansas

(If additional description is necessary, use BACK of this sheet)
Name of Plugging Contractor Flint Engineering and Construction Co.
Address 2375 W. Central, El Dorado, Kansas

STATE OF Kansas, COUNTY OF Butler, ss.
(employee of owner) or (owner or operator) of the above-described well, being first duly sworn on oath, says: That I have knowledge of the facts, statements, and matters herein contained and the log of the above-described well as filed and that the same are true and correct. So help me God.

(Signature) Richard C. Hausman

(Address) _____, 19 69

Subscribed and Sworn to before me this 2nd day of December, 19 69
Notary Public.



DRILLERS LOG

COMPANY:	International Hydrocarbons, Inc.
CONTRACTOR:	Aspen Drilling Co.
LEASE NAME	Equity #1
LOCATION:	SW NE Sec. 5-T34S-R5W Harper County, Kansas
ELEVATION:	1265' K.B.
SURFACE CASING:	6 jts. (242') 8 5/8"
OIL STRING:	104 jts. (4623') 5 1/2"
COMMENCED:	September 14, 1969
COMPLETED:	October 4, 1969
ROTARY TOTAL DEPTH:	5009'

<u>FORMATION</u>	<u>DEPTH</u>	
Shale & Clay	40	
Red Bed & Shale	337	
Shale & Shells	875	
Shale & Shells w/lime	1190	Ran 6 jts. (242') 8 5/8" casing, set at 249' w/200 sacks. Cement circulated.
Shale & Lime	2360	Ran DST #1, 3775-3812'
Lime & Shale	2607	Ran DST #2, 5000-5009'
Shale	2757	
Lime & Shale	2785	Ran electric log.
Shalew/lime	3060	
Lime	3115	Ran 104 jts. (4623') 5 1/2" casing, set at 4620' with 125 cu. ft. cement.
Lime & Shale	3245	
Shale & Lime	3462	
Shale	3555	
Shale & Lime	3625	
Shale	3675	
Shale & Lime	3760	
Lime	3820	
Lime & Shale	3920	
Shale & Lime	3990	
Lime & Shale	4085	
Lime	4175	
Lime & Shale	4295	
Shale & Lime	4524	
Lime	4545	
Lime & Chert	4629	
Lime & Shale	4760	
Lime	4880	
Lime & Shale	4974	
Lime	4993	
Lime & Sand	5004	
Sand	5009	
RTD	5009	


RECEIVED
STATE CORPORATION COMMISSION
NOV 17 1969
CONSERVATION DIVISION
Wichita, Kansas

AFFIDAVIT

State of Kansas)
) ss:
County of Barton)

The undersigned, being duly sworn on oath, states that the above statement and log are a true and correct record and log of the well drilled at the location above described.

William S. Schachle
William S. Schachle, Affiant

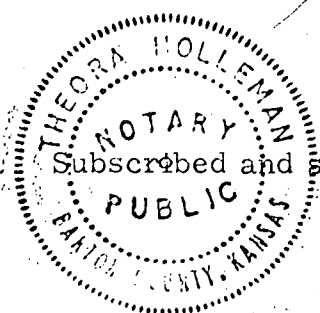

Subscribed and sworn to before me this 6th day of October, 1969.

Theora Holleman
Theora Holleman, Notary Public

My commission expires: April 18, 1972