


Give All Information Completely
Make Required Affidavit
Mail or Deliver Report to:
Conservation Division
State Corporation Commission
212 No. Market
Wichita, Kansas

WELL PLUGGING RECORD

Harper County, Sec. 33 Twp. 33S Rge. 9 (XX) (W) West
Location as "NE/CNW&SW" or footage from lines C NE NE

Lease Owner MACK OIL CO.
Lease Name Patterson Well No. 1
Office Address 812 Union Center Bldg., Wichita, Kansas 67202
Character of Well (completed as Oil, Gas or Dry Hole) Dry Hole
Date well completed October 23 19 66
Application for plugging filed October 23 19 66
Application for plugging approved October 23 19 66
Plugging commenced October 23 19 66
Plugging completed October 23 19 66
Reason for abandonment of well or producing formation Dry

NORTH

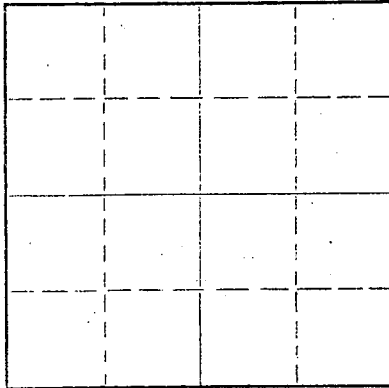

Locate well correctly on above
Section Plat

If a producing well is abandoned, date of last production _____ 19____
Was permission obtained from the Conservation Division or its agents before plugging was com-
menced? Yes

Name of Conservation Agent who supervised plugging of this well Archie Elving, Pratt, Kansas
Producing formation None Depth to top _____ Bottom _____ Total Depth of Well 4959 Feet
Show depth and thickness of all water, oil and gas formations.

OIL, GAS OR WATER RECORDS

FORMATION	CONTENT	FROM	TO	SIZE	CASING RECORD
					PUT IN PULLED OUT OCT 21 1966 CONSERVATION DIVISION Wichita, Kansas

Describe in detail the manner in which the well was plugged, indicating where the mud fluid was placed and the method or methods used in introducing it into the hole. If cement or other plugs were used, state the character of same and depth placed, from _____ feet to _____ feet for each plug set.

Plugged with 35 sax common cement @ 240'
20 sax common cement @ 50'
5 sax common cement rathole
Plugged at 2:00 p.m., October 23, 1966

(If additional description is necessary, use BACK of this sheet)

Name of Plugging Contractor MACK OIL CO.
Address P. O. Box 400, Duncan, Oklahoma 73533

STATE OF KANSAS, COUNTY OF SEDGWICK, ss.
Robert L. Harris (employee of owner) or (owner or operator) of the above-described

well, being first duly sworn on oath, says: That I have knowledge of the facts, statements, and matters herein contained and the log of the above-described well as filed and that the same are true and correct. So help me God.

(Signature) [Signature]

812 Union Center Bldg., Wichita, Kansas 67202
(Address)

SUBSCRIBED AND SWORN TO before me this 28th day of October, 19 66

Elizabeth F. Nice
Elizabeth F. Nice
Notary Public.

My commission expires September 21, 1968

MACK OIL COMPANY
Duncan, Oklahoma

DRILLERS WELL LOG

#1 Patterson

Commenced R. D.: 10-11-66
Completed R. D.: 10-22-66
Rotary Total Depth: 4952'

C NE NE - Section 33-33S-9W
Harper County, Kansas
Elevation: 1328' Kelly Bushing
Initial Production: Dry
Contractor: Mack Oil Company

<u>STRATA</u>	<u>DEPTH</u>
Surface Soil	0 - 216'
Shale	216 - 247
Shale & Shells	247 - 777
Shale	777 - 1430
Anhydrite	1430 - 1480
Lime & Shale	1480 - 2186
Lime	2186 - 2540
Lime & Shale	2540 - 2920
Lime	2920 - 3150
Lime & Shale	3150 - 3300
Shale & Lime	3300 - 3591
Lime	3591 - 3830
Lime & Shale	3830 - 3950
Shale & Lime	3950 - 4075
Lime	4075 - 4358
Lime & Shale	4358 - 4536
Lime & Chert	4536 - 4543
Cherty Lime	4543 - 4560
Lime & Chert	4560 - 4633
Lime	4633 - 4682
Cherty Lime	4682 - 4735
Chert	4735 - 4752
Lime & Shale	4752 - 4830
Lime	4830 - 4866
Chert & Lime	4866 - 4889
Lime	4889 - 4952'

RECEIVED
STATE CORPORATION COMMISSION
OCT 31 1966
CONSERVATION DIVISION
Wichita, Kansas

I hereby certify that the above is a true and correct log of said well as reflected by the daily drilling reports.

MACK OIL COMPANY

By Robert L. Harris
Robert L. Harris

Signed and sworn to in my presence this 28th day of October, 1966, by Robert L. Harris, representative for Mack Oil Company.

Elizabeth F. Nice
Elizabeth F. Nice, Notary Public

My Commission Expires September 21, 1968