


STATE OF KANSAS
STATE CORPORATION COMMISSION
CONSERVATION DIVISION
P. O. BOX 17027
WICHITA, KANSAS 67217

FORM CP-4

WELL PLUGGING RECORD

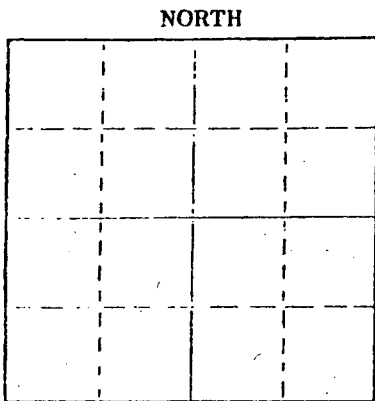

Locate well correctly on above Section Plat

Harper County, Sec. 29 Twp. 33 Rge. 6E 9 (W)
Location as "NE/CNW&SW" or footage from lines C-NW-NE
Lease Owner Cities Service Oil Company
Lease Name Tucker "D" Well No. 1
Office Address 209 E. William, 700 Sutton Pl., Wichita, Ks. 67202
Character of Well (completed as Oil, Gas or Dry Hole) D & A
Date well completed 2-28 1975
Application for plugging filed 2-28 1975
Application for plugging approved 2-28 1975
Plugging commenced 2-28 1975
Plugging completed 2-28 1975
Reason for abandonment of well or producing formation D & A

If a producing well is abandoned, date of last production 19
Was permission obtained from the Conservation Division or its agents before plugging was commenced? Yes, verbal.

Name of Conservation Agent who supervised plugging of this well G. R. Biberstein
Producing formation _____ Depth to top _____ Bottom _____ Total Depth of Well 5113 feet
Show depth and thickness of all water, oil and gas formations.

OIL, GAS OR WATER RECORDS

CASING RECORD

FORMATION	CONTENT	FROM	TO	SIZE	PUT IN	PULLED OUT
				8-5/8"	256	-0-

Describe in detail the manner in which the well was plugged, indicating where the mud fluid was placed and the method or methods used in introducing it into the hole. If cement or other plugs were used, state the character of same and depth placed, from _____ feet to _____ feet for each plug set.

Heavy Mud From 5110 to 250'.
Spot 35 Sacks Cement From 250' to 145'.
Heavy Mud From 145' to 40'.
10 Sacks Cement From 40' to Base of Cellar.

(If additional description is necessary, use BACK of this sheet)
Name of Plugging Contractor Gabbert & Jones
Address 209 E. William, 700 Sutton Pl., Wichita, Kansas 67202

STATE OF KANSAS COUNTY OF SEDGWICK ss.
W. J. Devaney (employee of owner) or (owner/operator) of the above-described

well, being first duly sworn on oath, says: That I have knowledge of the facts, statements, and matters herein contained and the log of the above-described well as filed and that the same are true and correct. So help me God.

Glenn E. Meier
STATE NOTARY PUBLIC
Sedgwick County, Kansas

(Signature) *[Signature]*
W. J. Devaney
209 E. William, 700 Sutton Pl. Wichita, Ks.
(Address)

Subscribed and sworn to before me this 10th day of March 1975

My commission expires 6/3/77
Glenn E. Meier Notary Public.

RECEIVED
STATE CORPORATION COMMISSION
MAR 12 1975
CONSERVATION DIVISION
Wichita, Kansas

GABBERT-JONES, INC.
WICHITA, KANSAS
DRILLERS' WELL LOG

Tucker "D" #1
Sec 29-33S-9W
Harper County Kansas

Commenced: 2-7-75

Completed: 2-28-75

OPERATOR: CITIES SERVICE

Depth		Formation	Remarks
From	to		
0	75	Redrock	
75	259	Redrock-Rebed	Ran 7 joints of used 8 5/8" csg
259	1542	Redbed-Shale	set @ 256' Cemented w/
1542	1753	Shale-Lime	200 sks Pozmix 2% CC
1753	2144	Lime-Shale	P.D. @ 12:15 a.m. 2-8-75
2144	2615	Shale-Lime	
2615	2936	Lime-Shale	
2936	3025	Shale	
3025	3167	Shale-Lime	
3167	3543	Lim-Shale	
3543	3742	Shale	
3742	3750	Sand-Shale	
3750	3853	Shale-Lime-Sand	
3853	3895	Shale-Lime	
3895	3939	Shale	
3939	3990	Shale-Lime	
3990	4002	Shale	
4002	4057	Lime-Shale	
4057	4112	Lime	
4112	4172	Lime-Shale	
4172	4291	Lime	
4291	4423	Shale-Lime	
4423	4875	Lime	
4875	4949	Shale-Sand	
4949	4987	Sand-Lime	
4987	5008	Shale	
5008	5053	Sandy Dolo-Shale	
5053	5110	Arb	
	5110 TD		DRY & ABANDONED

RECEIVED
STATE CORPORATION COMMISSION
MAR 12 1975
CONSERVATION DIVISION
Wichita, Kansas

I, James S. Sutton, II certify this is a correct copy of the Drillers' Log for the well drilled Sec 29-33S-9W Harper County Kansas to the best of my knowledge and belief.


JAMES S. SUTTON II

STATE OF KANSAS)
) SS
COUNTY OF SEDGWICK)

Before me, the undersigned, a Notary Public within and for said County and State, on this 7th day of March, 1975, personally appeared James S. Sutton II to me personally known to be the identical person who executed the within and foregoing instrument and acknowledged to me that he executed the same as his free and voluntary act and deed for the uses and purposes therein set forth.

IN WITNESS WHEREOF, I have hereunto set my hand and official seal the day and year last above written.


MARJORIE HALL-NOTARY PUBLIC

My Commission Expires: November 29th, 1975