

STATE OF KANSAS  
STATE CORPORATION COMMISSION

Form CP-4


WELL PLUGGING RECORD

Give All Information Completely  
Make Required Affidavit  
Mail or Deliver Report to:  
Conservation Division  
State Corporation Commission  
211 No. Broadway  
Wichita, Kansas

HARPER County. Sec. 25 Twp. 33S Rge. (E) 9 (W)

Location as "NE/CNW'SW" or footage from lines CENTER NW/4 NW/4  
Lease Owner WOOD OIL COMPANY  
Lease Name WHALEY Well No. 1  
Office Address 800 MIDSTATES BUILDING, TULSA, OKLAHOMA 74103  
Character of Well (completed as Oil, Gas or Dry Hole) DRY HOLE  
Date well completed 2 SEPTEMBER 19 64  
Application for plugging filed 2 SEPTEMBER 19 64  
Application for plugging approved 2 SEPTEMBER 19 64  
Plugging commenced 2 SEPTEMBER 19 64  
Plugging completed 2 SEPTEMBER 19 64  
Reason for abandonment of well or producing formation DRY HOLE

NORTH

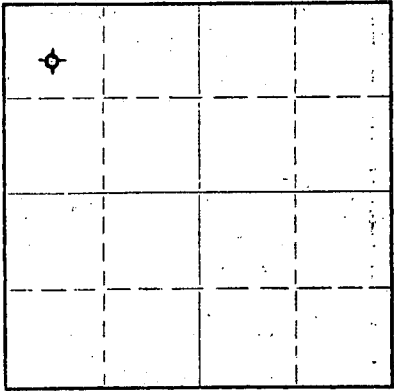

Locate well correctly on above  
Section Plat

If a producing well is abandoned, date of last production NONE 19  
Was permission obtained from the Conservation Division or its agents before plugging was commenced? YES

Name of Conservation Agent who supervised plugging of this well ARCHIE V. ELVING  
Producing formation NONE Depth to top Bottom Total Depth of Well 4605' RB Feet  
Show depth and thickness of all water, oil and gas formations.

OIL, GAS OR WATER RECORDS

CASING RECORD

FORMATION	CONTENT	FROM	TO	SIZE	PUT IN	PULLED OUT
SURFACE HOLE	WATER	SURFACE	251' RB	8 5/8" OD	24.5'	LEFT IN
(SEE ATTACHED LOG)						

Describe in detail the manner in which the well was plugged, indicating where the mud fluid was placed and the method or methods used in introducing it into the hole. If cement or other plugs were used, state the character of same and depth placed, from feet to feet for each plug set.

FILLED HOLE WITH HEAVY DRILLING MUD TO 250', SET PLUG AND CEMENTED WITH 28 SACKS CEMENT,  
FILLED HOLE WITH DRILLING MUD, SET PLUG AND CEMENTED WITH 10 SACKS CEMENT AT 40', PUT 2  
SACKS CEMENT IN RAT HOLE.

RECEIVED  
STATE CORPORATION COMMISSION

SEP 9 1964

CONSERVATION DIVISION  
Wichita, Kansas

(If additional description is necessary, use BACK of this sheet)  
Name of Plugging Contractor REX & MORRIS DRILLING COMPANY  
Address P. O. BOX 334, EL DORADO, KANSAS 67042

STATE OF KANSAS, COUNTY OF BUTLER, ss.  
A. H. FISHER (employee of owner) or (owner or operator) of the above-described well, being first duly sworn on oath, says: That I have knowledge of the facts, statements, and matters herein contained and the log of the above-described well as filed and that the same are true and correct. So help me God.

(Signature) *A. H. Fisher*  
P. O. BOX 334, EL DORADO, KANSAS 67042  
(Address)

SUBSCRIBED AND SWORN TO before me this 5TH day of SEPTEMBER 19 64

My commission expires 8 AUGUST 1966  
ELIZABETH DESCHNER Notary Public.

Elevation 1324' IB  
1319' CL

WHALE #1

Lead Oil Company

Total Depth: 4605' IB  
Contractor: Rex & Morris  
Commenced: 8-24-64  
Completed: 9-2-64  
Initial Prod.: B. & A.

Location: Center NW/4 NE/4  
Section 25-33E-09  
Harvey County, Kansas

Casing Record:  
8 5/8" OD @ 251' w/160 cwt

FORMATION	DEPTH
Surface Hole	251'
Shale	740'
Shale and Lins	1300'
Lins	1960'
Lins and Shale	2380'
Shale and Lins	3350'
Shale, Sand and Lins	3627'
Shale	3749'
Sand	3841'
Lins and Shale	3920'
Shale	3998'
Lins	4436'
Lins and Shale	4502'
Chert	4520'
Lins	4605'

S.T.D.

REC  
STATE CORP  
SEP 9 1964  
CONSERVA  
Wichita

I hereby certify the foregoing statements are true and correct to the best of my knowledge and belief.

Rex & Morris Drilling Company

By A. H. Fisher  
A. H. Fisher

STATE OF KANSAS  

Subscribed and sworn to before me, a Notary Public, this 1st day of September, 1964.

Elizabeth Reschner  
Elizabeth Reschner, Notary Public

My commission expires: August 8, 1965.