

STATE OF KANSAS
STATE CORPORATION COMMISSION


WELL PLUGGING RECORD

Give All Information Completely
Make Required Affidavit
Mail or Deliver Report to
Conservation Division
State Corporation Comm.
245 North Water
Wichita, KS 67202

Harper County. Sec. 23 Twp. 23 Rge. 9 E/W
Location as "NE/CNW $\frac{1}{4}$ SW $\frac{1}{4}$ " or footage from lines _____

Lease Owner NE NE SW
Leben oil corp
Lease Name Hughbanks Well No. 1

Office Address Box 81 Eldorado, KS
Character of Well (Completed as Oil, Gas or Dry Hole) _____

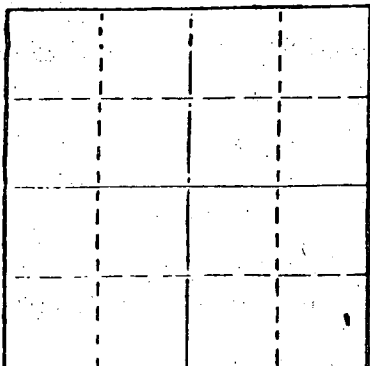

Locate well correctly on above
Section Plat

Date Well completed _____ 19____
Application for plugging filed _____ 19____
Application for plugging approved _____ 19____
Plugging commenced 4-15- 1981
Plugging completed 4-17- 1981

Reason for abandonment of well or producing formation _____
If a producing well is abandoned, date of last production _____ 19____

Was permission obtained from the Conservation Division or
its agents before plugging was commenced? Yes

Name of Conservation Agent who supervised plugging of this well Mark Heiler
Producing formation _____ Depth to top _____ Bottom _____ Total Depth of Well 4492
Show depth and thickness of all water, oil and gas formations.

OIL, GAS OR WATER RECORDS

CASING RECORD

FORMATION	CONTENT	FROM	TO	SIZE	PUT IN	PULLED OUT
				5 1/2		2,713.70

Describe in detail the manner in which the well was plugged, indicating where the mud fluid was placed and the method or methods used in introducing it into the hold. If cement or other plugs were used, state the character of same and depth placed, from _____ feet to _____ feet for each plug set. Sand back to 2690 and put in 5 sacks of cement. Haliburton put in 8 holes, 10 sacks of gel, 15 sacks of gel with 195 of cement.

STATE CORPORATION COMMISSION
RECEIVED

APR 20 1981

04-24-81


(If additional description is necessary, use BACK OF this sheet)

Name of Plugging Contractor H & H Harris

STATE OF Kansas COUNTY OF Harper, ss.
Mark Heiler (employee of owner) or (owner or operator)
of the above-described well, being first duly sworn on oath, says: That I have knowledge of the facts, statements, and matters herein contained and the log of the above-described well as filed and that the same are true and correct. So help me God.

(Signature) Mark Heiler
101 E 7th APTS Hutchinson, KS 67501
(Address)

SUBSCRIBED AND SWORN TO this 17 day of Apr, 1981

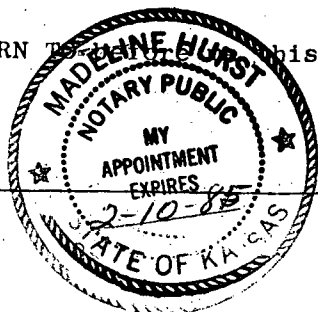

Madeline Hurst
Notary Public.

My commission expires _____