


STATE OF KANSAS
STATE CORPORATION COMMISSION

Form CP-4

Give All Information Completely
Make Required Affidavit
Mail or Deliver Report to:
Conservation Division
State Corporation Commission
211 No. Broadway
Wichita, Kansas

WELL PLUGGING RECORD

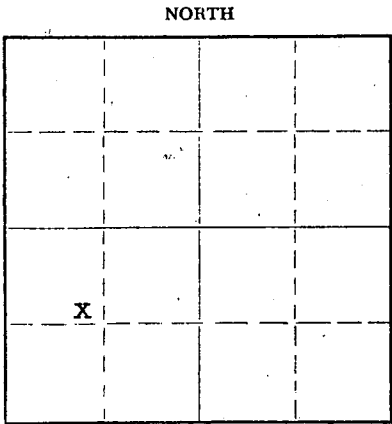

Locate well correctly on above
Section Plat

Barber County, Sec. 34 Twp. 32S Rge. 13W (E) (W)

Location as "NE/CNW/SW" or footage from lines C-SE-NW-SW

Lease Owner J. M. HUBER CORPORATION

Lease Name Magnison Well No. 1

Office Address PO Box 7508 Lakeside Sta, Oklahoma City, Okla.

Character of Well (completed as Oil, Gas or Dry Hole) Dry Hole

Date well completed April 1, 19 63

Application for plugging filed by telephone, April 1, 19 63

Application for plugging approved by telephone April 1, 19 63

Plugging commenced April 1, 19 63

Plugging completed 6:00 A.M., April 2, 19 63

Reason for abandonment of well or producing formation Dry hole

If a producing well is abandoned, date of last production ----- 19

Was permission obtained from the Conservation Division or its agents before plugging was commenced? Yes

Name of Conservation Agent who supervised plugging of this well Archie Elving

Producing formation None Depth to top Bottom Total Depth of Well 4655 Feet

Show depth and thickness of all water, oil and gas formations.

OIL, GAS OR WATER RECORDS

CASING RECORD

FORMATION	CONTENT	FROM	TO	SIZE	PUT IN	PULLED OUT
				8-5/8	411	- - - - -

Describe in detail the manner in which the well was plugged, indicating where the mud fluid was placed and the method or methods used in introducing it into the hole. If cement or other plugs were used, state the character of same and depth placed, from _____ feet to _____ feet for each plug set.

Hole was filled with mud to 240' Howco Plug @ 240' with 1/4 sack hulls and 20 sacks cement. Filled hole with mud to 40' HOWCO Plug @ 40' with 1/4 sack hulls and 10 sacks Cement. Put 2 sacks cement in rat hole.

RECEIVED
STATE CORPORATION COMMISSION

APR 22 1963

CONSERVATION DIVISION
Wichita, Kansas

(If additional description is necessary, use BACK of this sheet)

Name of Plugging Contractor Bowers Drilling Company
Address Union Center Building, Wichita, Kansas

STATE OF Oklahoma, COUNTY OF Oklahoma, ss.
Floyd L. Meade

(employee of owner) or (owner or operator) of the above-described well, being first duly sworn on oath, says: That I have knowledge of the facts, statements, and matters herein contained and the log of the above-described well as filed and that the same are true and correct. So help me God.

(Signature)

Floyd L. Meade

P O Box 7508 Lakeside Sta. Oklahoma City
(Address) Oklahoma

SUBSCRIBED AND SWORN to before me this 8th day of April, 19 63

Lydial M. Woods

Notary Public.

My commission Expires

March 7, 1967



WELL LOG

COMPANY: J. M. Huber Corporation
 CONTRACTOR: Bowers Drilling Company, Inc.
 FARM: Magnison #1
 LOCATION: C SE/4 NW/4 SW/4
 Section 34-32S-13W
 Barber County, Kansas
 COMMENCED: 3-18-63
 COMPLETED: 4-2-63
 ELEVATION: 1821 D. F.

0	-	752	Redbed and shale
752	-	1000	Redbed and shale
1000	-	1935	Shale
1935	-	2905	Lime and Shale
2905	-	3007	Shale
3007	-	3950	Lime and Shale
3950	-	4000	Shale-Lime - Douglas Sand
4000	-	4403	Lime and Shale
4403	-	4445	Lime
4445	-	4545	Lime and Shale
4545	-	4630	Lime
4630	-	4655	Mississippi
4655			Total Depth

RECEIVED
 STATE CORPORATION COMMISSION
 MAY 17 1963
 CONSERVATION DIVISION
 Wichita, Kansas

LOG TOPS:


Heebner	3910	Base K. C.	4452
Toronto	3928	Marmaton	4532
1st Douglas Sand	3989	Miss. Chert	4608
Douglas Sand	4055	Massy Zone	4566
Lansing	4094	Miss. Lime	4630

STATE OF KANSAS)
) SS
 COUNTY OF SEDGWICK)

I, Emil E. Bowers, do hereby certify that the above and foregoing is a true and correct copy of the copy of the log of the Magnison #1, C SE NW SW Section 34-32S-13W, Barber County, Kansas, as reflected by the files of Bowers Drilling Company, Inc.


 Emil E. Bowers

Subscribed and sworn to before me, a Notary Public in and for Sedgwick County, Kansas, this 22 day of April, 1963.

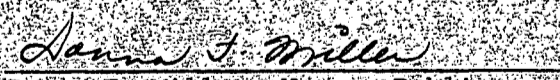
 Donna F. Miller, Notary Public

My commission expires May 1, 1966.