


STATE OF KANSAS
STATE CORPORATION COMMISSION

WELL PLUGGING RECORD

Give All Information Completely
Make Required Affidavit
Mail or Deliver Report to:
Conservation Division
State Corporation Commission
212 North Market, Insurance Bldg.
Wichita, Kansas

Barber County, Sec. 35 Twp. 32 Rge. 13 (E) W (W)

NORTH

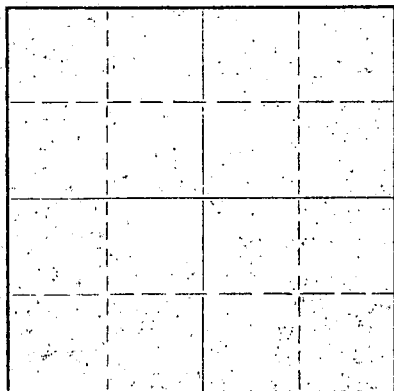

Locate well correctly on above
Section Plat

Location as "NE/CNW/SW" or footage from lines C SE SE
Lease Owner Morgenstern & Specter, Inc.
Lease Name Lonkers Well No. A-1
Office Address Russell, Kansas
Character of Well (completed as Oil, Gas or Dry. Hole) oil
Date well completed 7-28-53 19
Application for plugging filed October 26, 1960 19
Application for plugging approved October 27, 1960 19
Plugging commenced 11-3-60 19
Plugging completed 11-12-60 19
Reason for abandonment of well or producing formation Depleted.

If a producing well is abandoned, date of last production _____ 19
Was permission obtained from the Conservation Division or its agents before plugging was commenced? yes

Name of Conservation Agent who supervised plugging of this well Fred Hample
Producing formation Tongonoxie Sand Depth to top 3805 Bottom 3820 Total Depth of Well 3848 Feet
Show depth and thickness of all water, oil and gas formations.

OIL, GAS OR WATER RECORDS

CASING RECORD

FORMATION	CONTENT	FROM	TO	SIZE	PUT IN	PULLED OUT
				8-5/8"	492'	None
				5-1/2"	3820'	2798'

Describe in detail the manner in which the well was plugged, indicating where the mud fluid was placed and the method or methods used in introducing it into the hole. If cement or other plugs were used, state the character of same and depth placed, from _____ feet to _____ feet for each plug set.

Checked hole to 3810' and found it clear.
Ran sand from 3810' to 3770' and dumped 4 sacks of cement @ 3770' with dump bailer. Pulled 5 1/2" casing, mudded hole to 340', set 10' rock bridge to 330' and ran 35 sacks of cement @ 330'.
Mudded hole to 40' and set 10' rock bridge to 30'. Ran 10 sacks of cement to base of cellar.

PLUGGING COMPLETE.

RECEIVED
STATE CORPORATION COMMISSION

MAY 6 1963

CONSERVATION DIVISION
Wichita, Kansas

Name of Plugging Contractor Knight Casing Pulling Co.
Address Chase, Kansas

STATE OF Kansas, COUNTY OF Rice, ss.
Noel J. Knight (employee of owner) or (owner or operator) of the above-described well, being first duly sworn on oath, says: That I have knowledge of the facts, statements, and matters herein contained and the log of the above-described well as filed and that the same are true and correct. So help me God.

(Signature) Noel J. Knight
Chase, Kansas
(Address)

SUBSCRIBED AND SWORN TO before me this 15th day of November, 19 60

My commission expires May 20, 1964

Milton J. Volin
Notary Public.



WELL LOG BUREAU—KANSAS GEOLOGICAL SOCIETY
503 East Murdock, Wichita, Kansas

COPY


Company: SKELLY OIL CO.
Farm: Lonker "A" No. 1

SEC. 35 T. 32 R. 13W
CSE SE
660' fr EL 660' fr SL

Total Depth. 3820
Comm. 7-16-53 Comp. 7-28-53
Shot or Treated.
Contractor. Chas. Hulme Drilling Co.
Issued. 9-5-53

County Barber

KANSAS

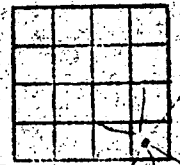

Elevation. 1642 DF

Production. 80,850,000 Gas

CASING:

8 5/8 @ 496' w/ 300 sx cem.
5 1/2 @ 3806' w/ 150 sx cem.

Figures indicate Bottom of Formations.

sand	100
clay & shale	440
shale & shells	496
clay	725
shale & shells	912
anhydrite & shells	940
shale	1120
shale & shells	1620
sandy lime	1785
lime	2265
lime & shale	2505
shale & shells	2615
shale	2835
shale & shells	2940
shale & lime	3015
lime	3180
lime & shale	3240
lime	3440
shale	3525
shale & lime	3675
shale & sand	3820
Total Depth	

TOPS:

Elgin sand	3586
Heebner	3714
Douglas	3723
Tonganoxie sand	3805

DST #1: 3792-3820, open 15 min. gas
to surf. 1 min. flowed thru 2" opening
15 min.; 1st 5 min: 8,810 MCF, next
10 min.; 8,940 MCF, rec. 2' condensate
BHP 1175# IFP 1025# FFP 1155#

Ran Schlumberger

Producing Formation: Tonganoxie sand 3806-3820

Gas 3806-3820