

RECEIVED  
STATE CORPORATION COMMISSION

JUL 1 1974 Form CP-4

WELL PLUGGING RECORD

CONSERVATION DIVISION  
Wichita, Kansas

STATE OF KANSAS  
STATE CORPORATION COMMISSION

Give All Information Completely  
Make Required Affidavit  
Mail or Deliver Report to:  
Conservation Division  
State Corporation Commission  
212 No. Market  
Wichita, Kansas 67202

Barber County, Sec. 36 Twp. 32S Rge. (E) 13 (W)

Location as "NE/CNW&SW" or footage from lines SW/4 NW/4

Lease Owner Clarke Oilfield Service

Lease Name Lonker Well No. A-2

Office Address Box 187, Medicine Lodge, Kansas 67104

Character of Well (completed as Oil, Gas or Dry Hole) Gas

Date well completed 11 - 29 19 53

Application for plugging filed 4 - 15 19 74

Application for plugging approved 4 - 16 19 74

Plugging commenced 4 - 30 19 74

Plugging completed 6 - 27 at 4 P.M. 19

Reason for abandonment of well or producing formation Not productive


If a producing well is abandoned, date of last production Never 19

Was permission obtained from the Conservation Division or its agents before plugging was commenced? Yes

Name of Conservation Agent who supervised plugging of this well Russell Biberstein

Producing formation Douglas Depth to top Bottom Total Depth of Well 3888 Feet

Show depth and thickness of all water, oil and gas formations.

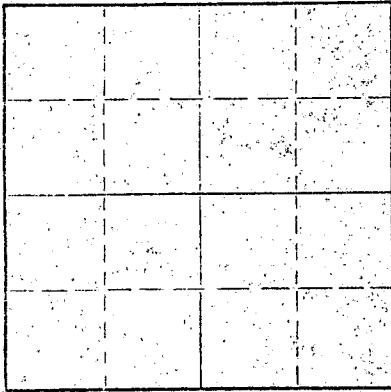

Locate well correctly on above Section Plat

OIL, GAS OR WATER RECORDS

CASING RECORD

FORMATION	CONTENT	FROM	TO	SIZE	PUT IN	PULLED OUT
				10 3/4	550	None
				7"	3888	2560

Describe in detail the manner in which the well was plugged, indicating where the mud fluid was placed and the method or methods used in introducing it into the hole. If cement or other plugs were used, state the character of same and depth placed, from \_\_\_\_\_ feet to \_\_\_\_\_ feet for each plug set.

Dump in Sand - From 3853 to 3653

6 sacks of cement with dump bailer.

Cement. From 3653 to 3625.

Ripped pipe at 3100 - 3000 - 2900 - 2800 - 2700-2600 - 2560.

Built wood bridge at 200 ft. Rock from 200 to 190 ft.

5 yards of Ready Mix to surface.

(If additional description is necessary, use BACK of this sheet)

Name of Plugging Contractor Clarke Oilfield Service.

Address Box 187, Medicine Lodge, Kansas 67104

STATE OF Kansas COUNTY OF Barber ss.  
Elma R. Margenstern (employee of owner) or (owner or operator) of the above-described well, being first duly sworn on oath, says: That I have knowledge of the facts, statements, and matters herein contained and the log of the above-described well as filed and that the same are true and correct. So help me God.

(Signature) Elma R. Margenstern  
Medicine Lodge, Kansas (Address)

Subscribed and sworn to before me this 29th day of June 1974

Jessie Hamilton  
Notary Public.

