


STATE OF KANSAS
STATE CORPORATION COMMISSION

WELL PLUGGING RECORD

Give All Information Completely
Make Required Affidavit
Mail or Deliver Report to:
Conservation Division
State Corporation Commission
211 No. Broadway
Wichita, Kansas

Harper County, Sec. 9 Twp. 34S Rge. 6W-XXX (W)
Location as "NE/CNW/SW" or footage from lines C SE SW
Lease Owner Prime Drilling Company & Benedict Oil Associates
Lease Name Hallman Well No. 1
Office Address 814 Union Center, Wichita, Kansas
Character of Well (completed as Oil, Gas or Dry Hole) Dry Hole
Date well completed December 14 19 59
Application for plugging filed December 14 19 59
Application for plugging approved December 14 19 59
Plugging commenced December 14 19 59
Plugging completed December 14 19 59
Reason for abandonment of well or producing formation no oil or gas found
in commercial quantities
If a producing well is abandoned, date of last production _____ 19____
Was permission obtained from the Conservation Division or its agents before plugging was commenced? yes

NORTH

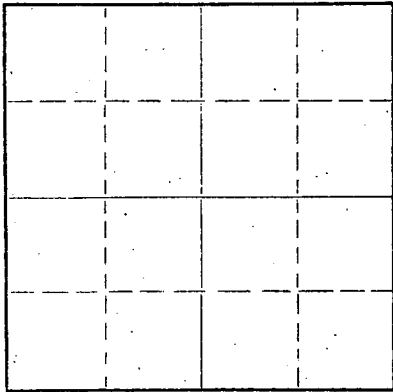

Locate well correctly on above
Section Plat

Name of Conservation Agent who supervised plugging of this well Fred Hampel
Producing formation _____ Depth to top _____ Bottom _____ Total Depth of Well 5070 Feet
Show depth and thickness of all water, oil and gas formations.

OIL, GAS OR WATER RECORDS

CASING RECORD

FORMATION	CONTENT	FROM	TO	SIZE	PUT IN	PULLED OUT
				8-5/8"	281'	none

Describe in detail the manner in which the well was plugged, indicating where the mud fluid was placed and the method or methods used in introducing it into the hole. If cement or other plugs were used, state the character of same and depth placed, from _____ feet to _____ feet for each plug set.

Filled hole with extra heavy rotary mud from total depth to 240'. Set Plug #1 at 240' cemented with 18 sacks cement.
Filled hole with extra heavy rotary mud from Plug #1 to 35', set Plug #2 at 35' cemented with 10 sacks cement.


Plugged Rat Hole with 2 sacks cement.

RECEIVED
CORPORATION COMMISSION
DEC 21 1959
CONSERVATION DIVISION
Wichita, Kansas

(If additional description is necessary, use BACK of this sheet)
Name of Plugging Contractor Prime Drilling Company
Address 814 Union Center, Wichita, Kansas

STATE OF Kansas, COUNTY OF Sedgwick, ss.
R. R. McNicol (employee of owner) or (owner or operator) of the above-described well, being first duly sworn on oath, says: That I have knowledge of the facts, statements, and matters herein contained and the log of the above-described well as filed and that the same are true and correct. So help me God.

(Signature) R. R. McNicol
814 Union Center, Wichita, Kansas
(Address)

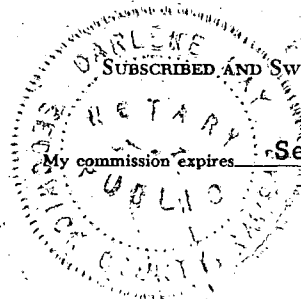

SUBSCRIBED AND SWORN to before me this 17th day of December, 19 59

Darlene May
Notary Public.

ROTARY DRILLING LOG

OPERATOR: Prime Drilling Company & Benedict
Oil Associates
HALIMAN NO. 1
C SE SW Sec. 9-34S-6W,
Harper County, Kansas

CONTRACTOR: Prime Drilling Company
COMM: 11-19-59
COMP: 12-14/59

Remarks: Set 8-5/8" surface casing
at 281' cemented with 225
sacks cement.

FORMATIONS:

Red Bed	75'
Red Rock & Shells	282'
Red Bed & Shell	480'
Shale & Lime	790'
Shale & Shells	980'
Anhydrite	1020'
Shale & Lime	1110'
Lime	1255'
Lime & Shale	1425'
Lime	1500'
Shale & Lime	1678'
Lime	1909'
Lime & sand	1940'
Lime	2080'
Shale & Lime	2320'
Lime	2750'
Lime & Shale	2950'
Lime	3070'
Lime & Shale	3270'
Lime	3300'
Lime & Shale	3335'
Lime	3510'
Lime & Shale	3635'
Shale & Lime	3707'
Lime	3747'
Lime & Shale	3833'
Lime	4375'
Lime & Shale	4402'
Shale & Lime	4455'
Lime	4503'
Shale & Lime	4590'
Lime	4628'
Shale & Lime	4673'
Lime	4922'
Lime & Shale	4970'
Lime	5047'
Sand	5070'
Rotary Total Depth (D&A)	5070'

RECEIVED
STATE CORPORATION COMMISSION
DEC 21 1959
CONSERVATION DIVISION
Wichita, Kansas

We certify the above log is true and
correct to the best of our knowledge
and belief.

PRIME DRILLING COMPANY

R-R. McNicol

R. R. McNicol