

STATE OF KANSAS
STATE CORPORATION COMMISSION

WELL PLUGGING RECORD

Give All Information Completely
Make Required Affidavit
Mail or Deliver Report to
Conservation Division
State Corporation Comm.
245 North Water
Wichita, KS 67202


Barber County. Sec. 28 Twp. 32S Rge. 13 E/W
Location as "NE/CNW $\frac{1}{4}$ /SW $\frac{1}{4}$ " or footage from lines
C E/2 SW SW

Lease Owner KEDCO Management Corporation
Lease Name HOPKING "D" Well No. 1
Office Address 816 Union Center, Wichita, Kansas 67202
Character of Well (Completed as Oil, Gas or Dry Hole)
Dry Hole

Date Well completed August 25 1976
Application for plugging filed (verbally) August 25 1976
Application for plugging approved (verbally) August 25 1976
Plugging commenced August 25 1976
Plugging completed August 25 1976
Reason for abandonment of well or producing formation
No commercial quantity of oil or gas encountered
If a producing well is abandoned, date of last production 19

Was permission obtained from the Conservation Division or its agents before plugging was commenced? Yes

Name of Conservation Agent who supervised plugging of this well G.R. Bitterstein
Producing formation _____ Depth to top _____ Bottom _____ Total Depth of Well _____
Show depth and thickness of all water, oil and gas formations.

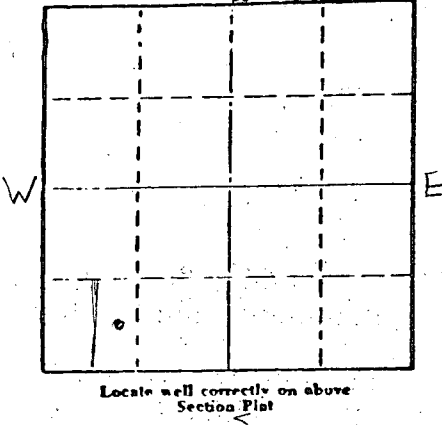

OIL, GAS OR WATER RECORDS

CASING RECORD

FORMATION	CONTENT	FROM	TO	SIZE	PUT IN	PULLED OUT
				8 5/8"	307' G.L.	None

Describe in detail the manner in which the well was plugged, indicating where the mud fluid was placed and the method or methods used in introducing it into the hold. If cement or other plugs were used, state the character of same and depth placed, from _____ feet to _____ feet for each plug set.

Plug with 35 sx. at 300'
15 sx. at 40'
5 sx. in Rathole

RECEIVED
STATE CORPORATION COMMISSION

SEP 02 1976

State Plugger: G.R. Bitterstein

CONSERVATION DIVISION
Wichita, Kansas

(If additional description is necessary, use BACK of this sheet)

Name of Plugging Contractor _____

STATE OF Kansas COUNTY OF Sedgwick, ss.
Jerry A. Langrehr-Exec. V.P.


(employee of owner) or (owner or operator) of the above-described well, being first duly sworn on oath, says: That I have knowledge of the facts, statements, and matters herein contained and the log of the above-described well as filed and that the same are true and correct. So help me God.

(Signature) Jerry A. Langrehr
801 Union Center, Wichita, Kansas 67202
(Address)

31st day of August 1976

Sandra Richman
Sandra Richman Notary Public.

July 21, 1979.

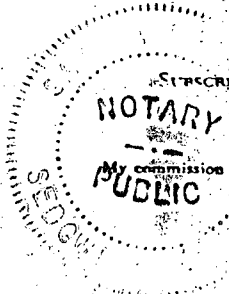

CONTRACTOR'S WELL LOG

OPERATOR: KEDCO Management Corporation
CONTRACTOR: Abercrombie Drilling, Inc.
WELL NAME: HOPKINS "D" #1, C E/2 SW SW
Section 28-32S-13W
Barber County, Kansas
SPUD DATE: August 11, 1976
COMPLETION DATE: August 25, 1976

0	102	Clay and Top Soil
102	320	Red Bed Shales
320	1553	Shale
1553	1579	Anhydrite
1579	2015	Shale
2015	2785	Lime & Shale
2785	2940	Shale & Lime
2940	3604	Lime & Shale
3604	3970	Lime
3970	4058	Lime & Shale
4058	4585	Lime
	4585	Rotary Total Depth

Spud at 8:30 a.m., 60' deep - 8-12-76. Drilled 317' of 12 1/4" hole, ran 8 joints of 8 5/8" 28# casing, set at 307' G.L. with 225 sx. of common cement, 3% Ca. Cl., 20% gel. Cement circulated, plug was down at 10:45 p.m. 8-12-76

T.D. 4585', Plug with 35 sx. at 300', 15 sx. at 40', 5 sx. in Rathole. Plug down at 8:00 p.m. 8-25-76. State Plugger G.R. Bitterstein.

RECEIVED
STATE CORPORATION COMMISSION

STATE OF KANSAS)
) SS
COUNTY OF SEDGWICK)

SEP 02 1976

CONSERVATION DIVISION
Wichita, Kansas

Jerry A. Langrehr, Executive Vice President of Abercrombie Drilling, Inc., does hereby state that the above and foregoing is a true and correct copy of the log of the HOPKINS "D" #1 C E/2 SW SW, Section 28-32S-13W, Barber County, Kansas.

ABERCROMBIE DRILLING, INC.

BY: Jerry A. Langrehr
Jerry A. Langrehr, Exec. V.P.

Subscribed and sworn to before me, a Notary Public, in and for the aforesaid county and state as of this 31st day of August, 1976.

Sandra Richman
Sandra Richman, Notary Public

My Commission Expires: July 21, 1979.

COPY