

STATE OF KANSAS
STATE CORPORATION COMMISSION

WELL PLUGGING RECORD

Give All Information Completely
Make Required Affidavit
Mail or Deliver Report to:
Conservation Division
State Corporation Commission
800 Bitting Building
Wichita, Kansas

Barber County, Sec. 29 Twp. 32S Rge. 13 (E) (W)

Location as "NE/CNW%SW%" or footage from lines NE/4 SW/4 SE/4

Lease Owner White Eagle Oil Company

Lease Name J. R. Hopkins Well No. 1

Office Address 619 First Nat'l Bldg., Tulsa 3, Oklahoma

Character of Well (completed as Oil, Gas or Dry Hole) Dry Hole

Date well completed June 25, 1954

Application for plugging filed June 25, 1954

Application for plugging approved June 25, 1954


Plugging commenced June 25, 1954

Plugging completed June 25, 1954

Reason for abandonment of well or producing formation Dry

If a producing well is abandoned, date of last production 19

Was permission obtained from the Conservation Division or its agents before plugging was commenced? yes

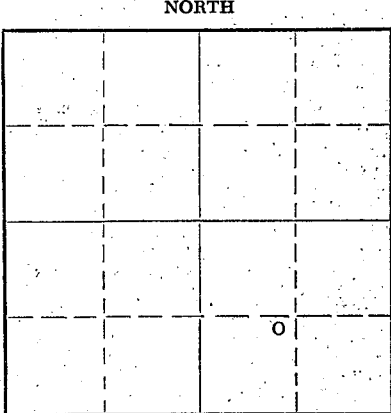

Locate well correctly on above Section Plat

Name of Conservation Agent who supervised plugging of this well M. A. Rives

Producing formation Depth to top Bottom Total Depth of Well 4507 Feet

Show depth and thickness of all water, oil and gas formations.

OIL, GAS OR WATER RECORDS

CASING RECORD

FORMATION	CONTENT	FROM	TO	SIZE	PUT IN	PULLED OUT
		0	312'	8 5/8"	315' O.A.	0

Describe in detail the manner in which the well was plugged, indicating where the mud fluid was placed and the method or methods used in introducing it into the hole. If cement or other plugs were used, state the character of same and depth placed, from feet to feet for each plug set.

4507' back to 300' with heavy rotary mud. Plug at 300' with 20 sacks cement. 300' to 45', heavy rotary mud. One plug with 10 sacks cement. Wired plug.

RECEIVED
STATE CORPORATION COMMISSION
JUL 7 - 1954
CONSERVATION DIVISION
Wichita, Kansas

(If additional description is necessary, use BACK of this sheet)
Name of Plugging Contractor Buick Drilling Inc.
Address P. O. Box 311, St. John, Kansas

STATE OF Kansas, COUNTY OF Stafford, ss.
H. R. Buick (employee of owner) or (owner or operator) of the above-described well, being first duly sworn on oath, says: That I have knowledge of the facts, statements, and matters herein contained and the log of the above-described well as filed and that the same are true and correct. So help me God.

(Signature) H. R. Buick
P. O. Box 331, St. John, Kansas
(Address)

SUBSCRIBED AND SWORN TO before me this 26th day of June, 1954

Roberta Shapiro
Notary Public.

My commission expires December 26, 1955

PLUGGING
FILE SEC 29 T 32 R 13W
BOOK PAGE 45 LINE 4

DRILLERS LOG

Hopkins #1
 Commenced R.D.: 6-4-54
 Completed R.D.: 6-24-54
 Total Depth: 4507'
 Casing Record: 315' 8 5/8"

NE SW SE Sec. 29-32S-13W
 Barber County, Kansas
 Elevation: 1677 D.F.
 Initial Prod.: None
 Contractor: Buick Drilling Inc.

STRATA	DEPTH
Sand and Shale	0 - 80
Red Bed	80 - 100
Red Bed, Shale and Shells	100 - 145
Sandy Shale and Red Bed	145 - 310
Red Bed, Shale and Shells	310 - 910
Anhydrite	910 - 920
Shale; Shells and Red Bed	920 - 1360
Shale and Shells	1360 - 1770
Lime and Shale	1770 - 2275
Sandy Lime and Shale	2275 - 2837
Lime and Shale	2837 - 2706
Shale with Lime streaks	2706 - 2810
Shale and Lime	2810 - 2896
Shale with Lime streaks	2896 - 3026
Shale and Lime	3026 - 3438
Shale and Broken Lime	3438 - 3510
Lime and Shale	3510 - 3585
Lime with shale streaks	3585 - 3638
Shale and Lime	3638 - 3864
Shale	3864 - 3870
Lime and Shale	3870 - 3990
Shale and chalky Lime	3990 - 3999
Lime	3999 - 4028
Lime and Shale	4028 - 4065
Lime	4065 - 4087
Sandy Lime	4087 - 4092
Lime	4092 - 4135
Lime and Shale	4135 - 4175
Lime and Chert	4175 - 4205
Lime	4205 - 4220
Lime and Shale	4220 - 4280
Lime	4280 - 4311
Lime and Shale	4311 - 4342
Lime	4342 - 4401
Lime and Shale	4401 - 4457
Lime and Chert	4457 - 4507 T.D.

RECEIVED
 STATE CORPORATION COMMISSION
 JUL 7 - 1954
 CONSERVATION DIVISION
 Wichita, Kansas

I hereby certify the above a true and correct drilling log as reflected by the drilling reports of the Buick Drilling Inc.

BUICK DRILLING INC.

H. R. Buick
 H. R. Buick, President

Signed and sworn to in my presence this 26th day of June, 1954, by H. R. Buick, President of the Buick Drilling Inc.

Roberta Shogren
 Notary Public

My commission expires Dec. 26, 1955.

PLUGGING
 FBI SEC 29 T 32 S 13W
 DOOR PAGE 43 LINE 4