


WELL PLUGGING RECORD

Give All Information Completely
Make Required Affidavit
Mail or Deliver Report to:
Conservation Division
State Corporation Commission
212 North Market, Insurance Bldg.
Wichita, Kansas

Barber County, Sec. 30 Twp. 32 Rge. 13 (E) (W)

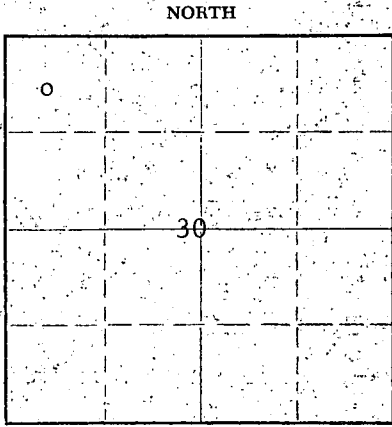

Locate well correctly on above Section Plat

Location as "NE/CNW&SW&" or footage from lines C NW NW
Lease Owner LIVINGSTON OIL COMPANY
Lease Name HOPKINS Well No. 1
Office Address P. O. Box 2848, Tulsa, Oklahoma 74101
Character of Well (completed as Oil, Gas or Dry Hole) Oil
Date well completed 9-24 1960
Application for plugging filed 12-16 1968
Application for plugging approved 12-17 1968
Plugging commenced 1-3 1969
Plugging completed 1-6 1969
Reason for abandonment of well or producing formation Depleted
If a producing well is abandoned, date of last production July 1968
Was permission obtained from the Conservation Division or its agents before plugging was commenced? Yes

Name of Conservation Agent who supervised plugging of this well R. J. Warren
Producing formation Mississippi Depth to top 4594 Bottom 4607 Total Depth of Well 4610 Feet
Show depth and thickness of all water, oil and gas formations.

OIL, GAS OR WATER RECORDS

CASING RECORD

FORMATION	CONTENT	FROM	TO	SIZE	PUT IN	PULLED OUT
Mississippi		4594	4607	13	272	
				5-1/2	4606	

Describe in detail the manner in which the well was plugged, indicating where the mud fluid was placed and the method or methods used in introducing it into the hole. If cement or other plugs were used, state the character of same and depth placed, from _____ feet to _____ feet for each plug set.
Filled with sand from 4610' to 4580'. Ran 5 sacks of cement from 4580' to 4550'. Set plug at 272', rock 272' to 260', ran 25 sacks of cement from 260' to 235'. Mudded from 235' to 15' and ran 15 sacks of cement from 15' to base of cellar.

RECEIVED
STATE CORPORATION COMMISSION
JAN 14 1969
CONSERVATION DIVISION
Wichita, Kansas

(If additional description is necessary, use BACK of this sheet)
Name of Plugging Contractor Glenn & Smith Pipe Pulling Company
Address Box 156, Ellinwood, Kansas

STATE OF OKLAHOMA, COUNTY OF TULSA, ss.
J. W. Randolph (employee of owner) or (owner or operator) of the above-described well, being first duly sworn on oath, says: That I have knowledge of the facts, statements, and matters herein contained and the log of the above-described well as filed and that the same are true and correct. So help me God.

(Signature) J. W. Randolph
General Superintendent
P. O. Box 2848, Tulsa, Oklahoma 74101
(Address)

SUBSCRIBED AND SWORN TO before me this 13th day of January, 1969

Margaret Heach
Notary Public.

My commission expires 8-10-69

