


WELL PLUGGING RECORD

Give All Information Completely
Make Required Affidavit
Mail or Deliver Report to:
Conservation Division
State Corporation Commission
211 No. Broadway
Wichita, Kansas

Ness County, Sec. 26 Twp. 19 S Rge. 25 (E) W (W)

NORTH

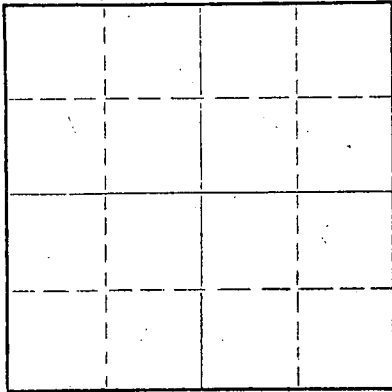

Locate well correctly on above Section Plat

Location as "NE/CNW/SW" or footage from lines C NE NW
Lease Owner Hellar Drilling Company
Lease Name Ford Well No. 1
Office Address 1014 Union Center, Wichita, Kansas
Character of Well (completed as Oil, Gas or Dry Hole) Dry Hole
Date well completed December 29 19 61
Application for plugging filed December 29 19 61
Application for plugging approved December 29 19 61
Plugging commenced December 29 19 61
Plugging completed December 29 19 61
Reason for abandonment of well or producing formation Failure to produce in commercial quantities

If a producing well is abandoned, date of last production _____ 19____
Was permission obtained from the Conservation Division or its agents before plugging was commenced? Yes

Name of Conservation Agent who supervised plugging of this well Gilbert Leiker
Producing formation _____ Depth to top _____ Bottom _____ Total Depth of Well 4471' Feet
Show depth and thickness of all water, oil and gas formations.

OIL, GAS OR WATER RECORDS

CASING RECORD

FORMATION	CONTENT	FROM	TO	SIZE	PUT IN	PULLED OUT
				8 5/8"	325'	

Describe in detail the manner in which the well was plugged, indicating where the mud fluid was placed and the method or methods used in introducing it into the hole. If cement or other plugs were used, state the character of same and depth placed, from _____ feet to _____ feet for each plug set.

Bottom Plug 320' 20 sacks
Top Plug 40' 1/2 sack hulls, 10 sacks cement

RECEIVED
STATE CORPORATION COMMISSION

JAN 4 1962
1-4-62
CONSERVATION DIVISION
Wichita, Kansas

(If additional description is necessary, use BACK of this sheet)

Name of Plugging Contractor _____
Address _____

STATE OF KANSAS, COUNTY OF SEDGWICK, ss.
Richard A. Shelley (employee of owner) or (owner or operator) of the above-described well, being first duly sworn on oath, says: That I have knowledge of the facts, statements, and matters herein contained and the log of the above-described well as filed and that the same are true and correct. So help me God.

(Signature) Richard A. Shelley
205 Miller Building, Wichita, Kansas
(Address)

SUBSCRIBED AND SWORN to before me this 3rd day of January 19 62

My commission expires March 24, 1964

Levan M. Powers
Notary Public.



COMPANY: Hellar Drilling Company
1014 Union Center
Wichita, Kansas

15 135 01007 0000

Rotary Drilling Commenced: 12-12-61
Rotary Drilling Completed: 12-29-61

LOCATION: Ford No. 1
C. NE NW Sec. 26-19S-22W
Ness County, Kansas

RECEIVED
STATE CORPORATE COMMISSION

JAN 4 1962

CONSERVATION DIVISION
WICHITA, KANSAS

CONTRACTOR: Shelley-Miller Drilling Company
205 Miller Building
Wichita, Kansas

CASING RECORD: 8 5/8" 24# new casing set at 325' cemented with 225 sacks

L O G
(Measurements from top of Rotary Bushing to bottom of formation)

Cement Hard	325
Shale & Red Bed	950
Sand	1,150
Shale & Shell Sand	1,215
Shell Shale	1,300
Red Bed & Shale	1,496
Anhydrite	1,527
Shale & Red Bed	1,790
Shale & Shell	2,265
Shale & Lime	2,430
Lime, Shell & Shale	2,520
Lime	2,600
Lime broken	2,745
Lime	2,805
Red Bed, Shale, Lime	2,900
Shale & Lime	2,990
Lime & Shale	3,075
Shale & Lime	3,310
Lime & Shale	3,471
Lime	3,562
Lime & Shale	3,725
Shale & Lime	3,780
Lime & Shale	3,861
Lime	3,967
Lime & Shale	4,034
Lime	4,172
Lime & Shale	4,233
Lime	4,295
Lime & Shale	4,320
Lime	4,342
Lime & Shale	4,382
Cherty Lime	4,386
Lime & Cherty	4,416
Cherty Lime	4,441
Chert & Lime	4,471 Rotary T.D.

The undersigned, Richard A. Shelley, Partner of Shelley-Miller Drilling Company, hereby certifies in behalf of said company, that the above log is a true and correct log of the formation encountered in drilling the above well as reflected by the Daily Drilling Reports.

SHELLEY-MILLER DRILLING COMPANY

By

STATE OF KANSAS)
COUNTY OF SEDGWICK) SS

TO BE IT REMEMBERED, that on this 3rd day of January, 1962, before me, the undersigned, a Notary Public, duly commissioned in and for the county and state aforesaid, came Richard A. Shelley, Partner, and known to me to be the same person who executed the foregoing instrument of writing in behalf of Shelley-Miller Drilling Company as a Partner of said company, and he duly acknowledged the execution of the same for himself and for said company.

IN WITNESS WHEREOF, I have hereunto set my hand and official seal on the day and year last above written.

My Commission Expires:
March 24, 1964

Notary Public