15-135-19143-0000


Form CP-4

STATE OF KANSAS
STATE CORPORATION COMMISSION

Give All Information Completely
Make Required Affidavit
Mail or Deliver Report to:
Conservation Division
State Corporation Commission
211 No. Broadway
Wichita, Kansas

WELL PLUGGING RECORD

NORTH

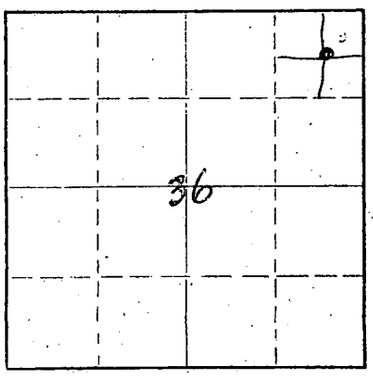

Locate well correctly on above Section Plat

Ness County. Sec. 36 Twp. 19S Rge. 22 (E) W (W)

Location as "NE/CNW¼SW¼" or footage from lines C-NE-NE

Lease Owner Socony Mobil Oil Company, Inc.

Lease Name H. L. Williams Estate Well No. 2

Office Address 300 N. Broadway, Wichita, Kansas 67202

Character of Well (completed as Oil, Gas or Dry Hole) Dry Hole

Date well completed 11-1-64 19

Application for plugging filed 11-5-64 19

Application for plugging approved 11-1-64 19

Plugging commenced 11-1-64 19

Plugging completed 11-1-64 19

Reason for abandonment of well or producing formation Drilled Dry

If a producing well is abandoned, date of last production 19

Was permission obtained from the Conservation Division or its agents before plugging was commenced? Yes

Name of Conservation Agent who supervised plugging of this well ELDON PETTY

Producing formation - Depth to top Bottom Total Depth of Well Feet

Show depth and thickness of all water, oil and gas formations.

OIL, CAS OR WATER RECORDS — CASING RECORD

FORMATION	CONTENT	FROM	TO	SIZE	PUT IN	PULLED OUT
None						

Describe in detail the manner in which the well was plugged, indicating where the mud fluid was placed and the method or methods used in introducing it into the hole. If cement or other plugs were used, state the character of same and depth placed, from feet to feet for each plug set.

Spotted 20 sacks cement @ 660'. Mudded to 300'. Spotted 20 sacks cement @ 300'. Mud up to 40'. Filled to surface with 10 sacks cement.

RECEIVED
STATE CORPORATION COMMISSION
NOV 6 1964
11-6-64
CONSERVATION DIVISION
Wichita, Kansas

RECEIVED
STATE CORPORATION COMMISSION
NOV 12 1964
CONSERVATION DIVISION
Wichita, Kansas

(If additional description is necessary, use BACK of this sheet)

Name of Plugging Contractor Peel Bros., Inc.

Address P.O. Box 359, Hoisington, Kansas

STATE OF Kansas, COUNTY OF Sedgwick, ss.

T. V. Herriage (employee of owner) or (owner or operator) of the above-described well, being first duly sworn on oath, says: That I have knowledge of the facts, statements, and matters herein contained and the log of the above-described well as filed and that the same are true and correct. So help me God.

(Signature) T. V. Herriage Dist. Group Supr.

300 N. Broadway, Wichita, Kansas 67202
(Address)

SUBSCRIBED AND SWORN TO before me this 5th day of November, 1964

Jack Bearden
Notary Public.

My commission expires 4-4-66

12-23-64

15 135 19 143 0000

DRILLER'S LOG

Well Owner: Mobil Oil Company
Farm Name: H. Williams Estate #2
Date Started: 10-21-64
Date Completed: 11-1-64
Total Depth: 4443

C NE NE
Section 36-19S-22W
Ness County, Kansas

Casing: 8-5/8" set at 352' cemented

Contractor: Peel Brothers, Inc.

Figures below indicate bottoms of formations:

Clay and Rock	0 to	60
Sand		1160
Red Bed and Shells		1255
Red Bed		1511
Anhydrite		1543
Shale and Shells		1775
Shale		2205
Shale and Lime		3335
Shale, Lime and Chalk		3510
Shale, Chalk and Lime		3655
Lime and Shale		3770
Lime and Chert		4423
Chert and Lime		4433
Lime		4443
Total Depth		4443

RECEIVED
STATE CORPORATION COMMISSION
NOV 24 1964
CONSERVATION DIVISION
Wichita, Kansas

This is to certify that the above information is to the best of our knowledge true and correct.

PEEL BROTHERS, INC.

Jack Mattocks

W. E. "Jack" Mattocks
Drilling Superintendent

SUBSCRIBED AND SWORN to before me this 4th day of November, 1964.

Edith S. Williamson
Notary Public

My Commission expires 6-21-66