


15-135-22108-0000

WELL PLUGGING RECORD

Give All Information Completely  
 Make Required Affidavit

COUNTY Ness SEC. 24 TWP. 19S RGE. 22 W  
 Location as in quarters or footage from lines:  
 SW SW SE

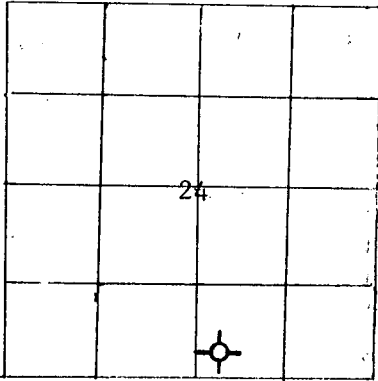

Locate Well  
 correctly on above  
 Section Platt.

Lease Owner Wild Boys & The Silver Bullet  
 Lease Name OUT ON BAIL Well No. 1  
 Office Address 815 N. Waco, Suite 3A, Wichita, Ks.  
 Character of Well (Completed as Oil, Gas or Dry Hole): Dry Hole  
 Date Well Completed 10-3-81  
 Application for plugging filed February 3, 1982  
 Plugging commenced 10-3-81 11:45 a.m.  
 Plugging completed 10-3-81 2:00 p.m.  
 Reason for abandonment of well or producing formation Non-commercial

Was permission obtained from the Conservation Division or it's  
 Agent's before plugging was commenced? Yes

Name of Conservation Agent who supervised plugging of this well Steve Durrant  
 Producing formation N/A Depth to top \_\_\_\_\_ bottom \_\_\_\_\_ T.D. 4452

Show depth and thickness of all water, oil and gas formations.

OIL, GAS OR WATER RECORDS

Casing Record

Formation	Content	From	To	Size	Put in	Pulled Out
Heebner		3741		8 5/8"	435'	
Lansing		3791				
Ft. Scott		4285				
Cherokee		4303				
Mississippi		4384				

Describe in detail the manner in which the well was plugged, indicating where the mud  
 fluid was placed and the method or methods used in introducing it into the hold. If cement  
 or other plugs were used, state the character of same and depth placed, from \_\_\_\_\_ feet  
 to \_\_\_\_\_ feet for each plug set.

70 sx at 780', 40 sx at 420', bridge plug and 10 sx at 40', 5 sx in rathole, 5 sx  
in mousehole. Common cement pumped into place.  
Cement plug from 780'-580', cement plug from 420'-305', wooden plug at 40', and  
cement to surface.  
Mud fluids are left in pits and backfilled in place when sufficiently dry.

(If additional description is necessary, use BACK of this sheet)

Name of Plugging Contractor Sun Oilwell Cementing

STATE OF Kansas COUNTY OF Sedgwick, ss.  
R. A. Christensen (employee of owner) or (~~owner or operator~~) of the  
 above-described well, being first duly sworn on oath, says: That I have knowledge of the  
 facts, statements, and matters herein contained and the log of the above-described well as  
 filed and that the same are true and correct. So help me God.

(Signature) RA Christensen  
 (Address) \_\_\_\_\_

SUBSCRIBED AND SWORN TO before me this 3rd day of February, 1982  
Donna Hale Ard  
 Notary Public.

My Commission expires: October 20, 1982

RECEIVED  
 STATE CORPORATION COMMISSION  
 FEB - 4 1982  
 DONNA HALE ARD  
 STATE NOTARY PUBLIC  
 SEDGWICK COUNTY, KANSAS  
 CONSERVATION DIVISION  
 Wichita, Kansas

2-4-82