


15-135-21185-0000

STATE OF KANSAS
STATE CORPORATION COMMISSION

Give All Information Completely
Make Required Affidavit
Mail or Deliver Report to
Conservation Division
State Corporation Commission
245 North Water
Wichita, KS 67202

FORM CP-4

WELL PLUGGING RECORD

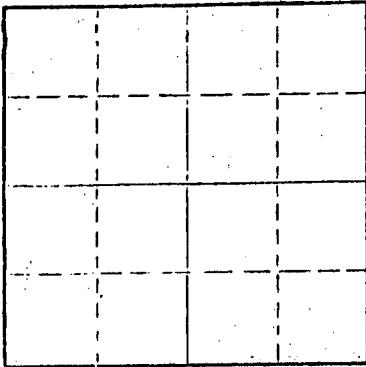

Locate well correctly on above
Section Plat

Ness County, Sec. 24 Twp. 19S Rge. 22 (X) (W)
Location as "NE/CNW/SW" or footage from lines C SW NW
Lease Owner Thunderbird Drilling, Inc.
Lease Name Schaben Well No. 1
Office Address 7701 E. Kellogg, Suite 780, Wichita, Kansas
Character of Well (completed as Oil, Gas or Dry Hole) Dry Hole
Date well completed 4-17-76 19
Application for plugging filed 4-17-76 19
Application for plugging approved 4-17-76 19
Plugging commenced 4-17-76 19
Plugging completed 4-17-76 19
Reason for abandonment of well or producing formation
Commercial quantities of oil not found
If a producing well is abandoned, date of last production 19
Was permission obtained from the Conservation Division or its agents before plugging was commenced? yes

Name of Conservation Agent who supervised plugging of this well Leo Massey - Hays, Kansas
Producing formation _____ Depth to top _____ Bottom _____ Total Depth of Well 4404 Feet
Show depth and thickness of all water, oil and gas formations.

OIL, GAS OR WATER RECORDS

CASING RECORD

FORMATION	CONTENT	FROM	TO	SIZE	PUT IN	PULLED OUT
				8 5/8"	420'	

Describe in detail the manner in which the well was plugged, indicating where the mud fluid was placed and the method or methods used in introducing it into the hole. If cement or other plugs were used, state the character of same and depth placed, from _____ feet to _____ feet for each plug set.

RECEIVED
STATE CORPORATION COMMISSION
AUG 26 1976
CONSERVATION DIVISION
Wichita, Kansas

Plug at 600' w/ 50 sx.
Plug at 300' w/ 25 sx.
Plug @ 40' w/ 10 sx.

(If additional description is necessary, use BACK of this sheet)
Name of Plugging Contractor Rains & Williamson Oil Co., Inc.
Address 435 Page Court, 220 W. Douglas, Wichita, Kansas 67202

STATE OF KANSAS COUNTY OF SEDGWICK
Wilson Rains, President of Rains & Williamson Oil Co., Inc. (employee of owner) or (owner or operator) of the above-described well, being first duly sworn on oath, says: That I have knowledge of the facts, statements, and matters herein contained and the log of the above-described well as filed and that the same are true and correct. So help me God.

(Signature) Wilson Rains
435 Page Court, 220 W. Douglas, Wichita, Kansas 67202 (Address)

RECORDED AND SWORN TO before me this 19th day of April, 1976
My commission expires October 4, 1979



Juanita M. Green
Notary Public.

WELL LOG

15-135-21185-0000

COMPANY Thunderbird Drilling, Inc.

SEC. 24 T. 19S R. 22W
LOC. C SW NW

FARM Schaben NO. 1


RIG. NO. 7

TOTAL DEPTH 4404'

COUNTY Ness
KANSAS

COMM. 4-5-76 COMP. 4-17-76

CONTRACTOR Rains & Williamson Oil Co., Inc.

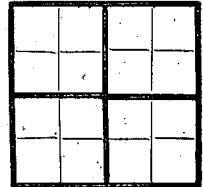

CASING

20 10
15 8 5/8" @ 420' w/ 260 sx., 2% gel, 3% cc.
12 6
13 5

ELEVATION

PRODUCTION D & A

FIGURES INDICATE BOTTOM OF FORMATIONS

Surface Soil	422
Shale	950
D. Sands	1152
Anhydrite	1529
Shale	1975
Shale and Lime	2480
Shale and Lime	3990
Lime	4377
Lime and Shale	4387
Lime	4404
<u>Rotary Total Depth</u>	<u>4404</u>

RECEIVED
STATE CORPORATION COMMISSION

AUG 26 1976

CONSERVATION DIVISION
Wichita, Kansas

State of KANSAS }
County of SEDGWICK } ss:

I, Wilson Rains, President of the Rains & Williamson Oil Co., Inc.

upon oath state that the above and foregoing is a true and correct copy of the log of the Schaben #1 well.

Wilson Rains
WILSON RAINS

Subscribed and sworn to before me this 19th day of April 19 76

My Commission Expires: October 4, 1979

Juanita M. Green
NOTARY PUBLIC
Juanita M. Green

