

15-135-30150-0000

STATE OF KANSAS
STATE CORPORATION COMMISSION


Form CP-4

WELL PLUGGING RECORD

Give All Information Completely
Make Required Affidavit
Mail or Deliver Report to:
Conservation Division
State Corporation Commission
211 No. Broadway
Wichita, Kansas

Ness County, Sec. 23 Twp. 19S Rge. (E) 22(W)
Location as "NE/CNW/SW" or footage from lines C NE SE
Lease Owner Pickrell Drilling Company
Lease Name Gillig Well No. 1
Office Address 705 4th National Bank Bldg, Wichita, Kansas
Character of Well (completed as Oil, Gas or Dry Hole) Dry Hole
Date well completed November 5, 19 65
Application for plugging filed November 5, 19 65
Application for plugging approved November 5, 19 65
Plugging commenced November 5, 19 65
Plugging completed November 5, 19 65
Reason for abandonment of well or producing formation Dry Hole

NORTH

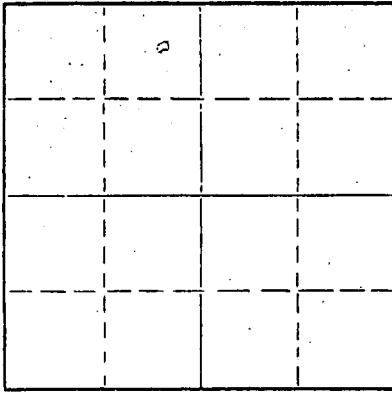

Locate well correctly on above
Section Plat

If a producing well is abandoned, date of last production 19
Was permission obtained from the Conservation Division or its agents before plugging was commenced? Yes

Name of Conservation Agent who supervised plugging of this well
Producing formation Depth to top Bottom Total Depth of Well 4410 Feet
Show depth and thickness of all water, oil and gas formations.


OIL, GAS OR WATER RECORDS

CASING RECORD

FORMATION	CONTENT	FROM	TO	SIZE	PUT IN	PULLED OUT
				8 5/8"	310'	None

Describe in detail the manner in which the well was plugged, indicating where the mud fluid was placed and the method or methods used in introducing it into the hole. If cement or other plugs were used, state the character of same and depth placed, from feet to feet for each plug set.

Heavy mud to 500', set plug with 20 sacks
cement. Heavy mud to 300', set plug with
20 sacks cement. Heavy mud to 40', set plug;
cemented with 10 sacks cement to bottom of
cellar. Plugged rat hole with 2 sacks cement

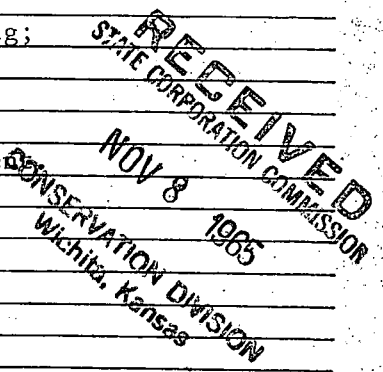

(If additional description is necessary, use BACK of this sheet)


Name of Plugging Contractor Pickrell Drilling Company
Address 705 4th National Bank Building, Wichita, Kansas

STATE OF KANSAS, COUNTY OF SEDGWICK, ss.

C. W. SEBITS (owner or operator) of the above-described well, being first sworn on oath, says: That I have knowledge of the facts, statements, and matters herein contained and the log of the above-described well as filed and that the same are true and correct. So help me God.

(Signature) C. W. Sebits
705 4th National Bank Bldg, Wichita, Kansas
(Address)

Subscribed and sworn to before me this 5th day of November, 19 65

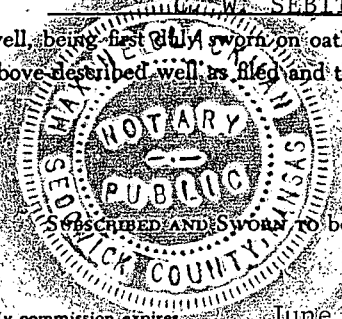

Maxine Blackman, Notary Public.

My commission expires June 21, 1966

ROTARY DRILLING LOG

15135 30150 0000

COMPANY: PICKRELL DRILLING COMPANY
705 4th National Bank Bldg.
Wichita, Kansas

Rotary Drilling Commenced 10-23-65

Rotary Drilling Completed 11--2-65

LOCATION: GILLIG No. 1, C NE SE Section 23-19S-22W, Ness County, Kansas

CONTRACTOR: **PICKRELL DRILLING COMPANY**
Wichita, Kansas

CASING RECORD: (15 jts) 8 5/8" surface casing set at 311', cemented with 165 sacks cement. Circulated. Completed 11:00 P.M. October 23, 1965. No oil string run, D & A.

LOG

(Figures indicate bottom of formation — measurements from top of rotary bushing.)

35	Soil & Clay	
85	Sand Rock & Shale	
311	Shale & Sand Streaks	<u>C. F. S.</u>
475	Shale	4380
1470	Shale, Sand & Shells	4390
1490	Shale & Shells	4395
1530	Anhydrite	4400
1790	Shale & Lime	4410
2220	Shale	
2370	Lime & Shale	<u>Slope Tests</u>
2490	Lime	2500
3695	Shale & Lime	3000
3790	Shale & Chalky Lime	3500
3930	Lime & Shale	4000
4000	Lime	
4383	Lime & Shale	<u>S. L. M.</u>
4410	Mississippian - RTD	3966
		4180
		4365

RECEIVED
STATE CORPORATION COMMISSION
NOV 8 1965
CONSERVATION DIVISION
Wichita, Kansas

The undersigned, C. W. SEBITS, Attorney-in-Fact for PICKRELL DRILLING COMPANY, hereby certifies in behalf of said Company, that the above is a true and correct log of the formation encountered in drilling the above well as reflected by the Daily Drilling Reports.

PICKRELL DRILLING COMPANY

By [Signature]
C. W. SEBITS, Attorney-in-Fact

STATE OF KANSAS

COUNTY OF SEDGWICK } ss.

On this 25th day of November, 1965, before me the undersigned, a Notary Public, in and for the County and State aforesaid, personally appeared C. W. SEBITS, to me known to be the identical person who subscribed the name of PICKRELL DRILLING COMPANY to the foregoing instrument as its Attorney-in-Fact and acknowledged to me that he executed the same as his free and voluntary act and deed, and as the free and voluntary act and deed of such company, for the uses and purposes therein set forth.

Given under my hand and seal of office the day and year last above written.

My commission expires June 21, 1966

[Signature]
Maxine Blackman, Notary Public