

Give All Information Completely  
Make Required Affidavit  
Mail or Deliver Report to:  
Conservation Division  
State Corporation Commission  
211 No. Broadway  
Wichita, Kansas

WELL PLUGGING RECORD

Ness County, Sec. 12 Twp. 20S Rge. 22W (X) (W)

Location as "NE/CNWxSWx" or footage from lines 83' E/C-NE-SE

Lease Owner Socony Mobil Oil Company, Inc.

Lease Name John Wittman, Jr. Well No. 1

Office Address 300 N. Broadway, Wichita, Kansas 67202

Character of Well (completed as Oil, Gas or Dry Hole) Well lost - casing failure

Date well completed \_\_\_\_\_ 19\_\_\_\_

Application for plugging filed 2-16-65 19\_\_\_\_

Application for plugging approved 2-17-65 19\_\_\_\_


Plugging commenced 2-10-65 19\_\_\_\_

Plugging completed 2-13-65 19\_\_\_\_

Reason for abandonment of well or producing formation Casing collapsed and was unable to repair same

If a producing well is abandoned, date of last production \_\_\_\_\_ 19\_\_\_\_

Was permission obtained from the Conservation Division or its agents before plugging was commenced? Yes

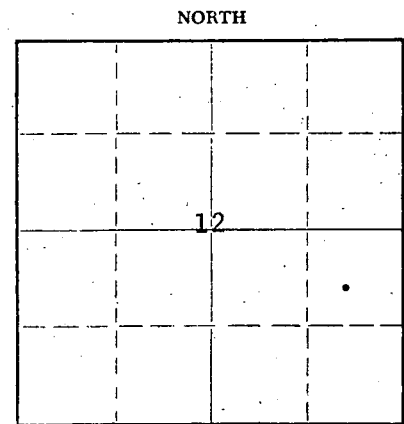

Locate well correctly on above Section Plat

Name of Conservation Agent who supervised plugging of this well Eldon Petty

Producing formation \_\_\_\_\_ Depth to top \_\_\_\_\_ Bottom \_\_\_\_\_ Total Depth of Well 4342 Feet

Show depth and thickness of all water, oil and gas formations.

OIL, GAS OR WATER RECORDS

CASING RECORD

| FORMATION | CONTENT | FROM | TO | SIZE   | PUT IN | PULLED OUT |
|-----------|---------|------|----|--------|--------|------------|
|           |         |      |    | 8 5/8" | 315'   | 0          |
|           |         |      |    | 5 1/2" | 4329'  | 2370'      |
|           |         |      |    |        |        |            |
|           |         |      |    |        |        |            |
|           |         |      |    |        |        |            |
|           |         |      |    |        |        |            |

Describe in detail the manner in which the well was plugged, indicating where the mud fluid was placed and the method or methods used in introducing it into the hole. If cement or other plugs were used, state the character of same and depth placed, from \_\_\_\_\_ feet to \_\_\_\_\_ feet for each plug set.

Cut off 5 1/2" casing at 2370' and pulled casing. Spotted 25 sacks cement plug at 620'. Loaded hole with mud, placed 20 sacks cement at 320' and 10 sacks from 35' to surface. P&A.

RECEIVED  
STATE CORPORATION COMMISSION

FEB 18 1965  
2-18-65  
CONSERVATION DIVISION  
Wichita, Kansas

(If additional description is necessary, use BACK of this sheet)

Name of Plugging Contractor Bill Hay Drilling Company

Address 2007 Polk St., Great Bend, Kansas

STATE OF Kansas, COUNTY OF Sedgwick, ss.

T. V. Herriage (employee of owner) ~~or (owner or operator)~~ of the above-described well, being first duly sworn on oath, says: That I have knowledge of the facts, statements, and matters herein contained and the log of the above-described well as filed and that the same are true and correct. So help me God.

(Signature) T. V. Herriage Dist. Acctg. Group Supr.

300 N. Broadway, Wichita, Kansas 67202  
(Address)

SUBSCRIBED AND SWORN TO before me this 16th day of February, 1965

Jack Bearden  
Notary Public.

My commission expires 4-4-66



14 6-21-66  
commission expires

NOTARY PUBLIC

SUBSCRIBED AND SHOWN to be true and correct on this 21st day of January, 1966.

Mendell C. 1961  
President

*Mendell C. 1961*

HELL BROTHERS, INC.

This is to certify that the above information is to the best of our knowledge true and correct.

|                     |      |
|---------------------|------|
| Clay and Rock       | 60   |
| Shale               | 860  |
| Sand                | 1075 |
| Red Bed and Shale   | 1720 |
| Argillite           | 1475 |
| Shale and Shells    | 2225 |
| Shale and Limestone | 3265 |
| Limestone and Shale | 3560 |
| Limestone           | 4308 |
| Chert               | 4330 |
| Limestone and Chert | 4372 |
| Total Depth         | 4372 |

Figures below indicate bottom of formations

Contractor: Hell Brothers, Inc.

casing: 8-5/8" set at 327' cemented  
 4" set at 432' cemented




15135-56013-0000