

STATE OF KANSAS  
STATE CORPORATION COMMISSION


15-135-2138-5 0000

WELL PLUGGING RECORD

Give All Information Completely  
Make Required Affidavit  
Mail or Deliver Report to  
Conservation Division  
State Corporation Comm.  
245 North Water  
Wichita, KS 67202

Ness County, Sec. 11 Twp. 20 Rge. 22 E/W  
Location as "NE/CNW $\frac{1}{4}$ SW $\frac{1}{4}$ " or footage from lines  
150' NE of NE NW

Lease Owner Vincent Oil Corporation  
Lease Name Schwiën 'B' Well No. 1  
Office Address 901 Union Center Building, Wichita 67202  
Character of Well (Completed as Oil, Gas or Dry Hole)  
Dry Hole

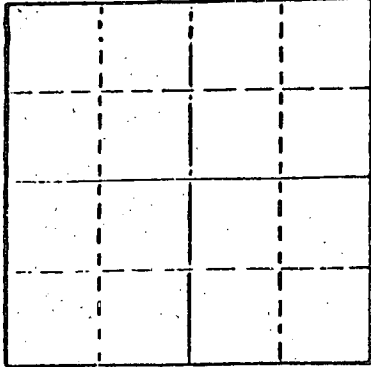

Locate well correctly on above  
Section Plot

Date Well completed 11/2/77 19  
Application for plugging filed 11/2/77 19  
Application for plugging approved 11/2/77 19  
Plugging commenced 11/2/77 19  
Plugging completed 11/2/77 19  
Reason for abandonment of well or producing formation

If a producing well is abandoned, date of last production 19

Was permission obtained from the Conservation Division or  
its agents before plugging was commenced? Yes

Name of Conservation Agent who supervised plugging of this well Leo Massey  
Producing formation Depth to top Bottom Total Depth of Well 4442

Show depth and thickness of all water, oil and gas formations.

OIL, GAS OR WATER RECORDS

CASING RECORD

FORMATION	CONTENT	FROM	TO	SIZE	PUT IN	PULLED OUT
	Surface	0	490	8-5/8	yes	no

Describe in detail the manner in which the well was plugged, indicating where the mud fluid was placed and the method or methods used in introducing it into the hold. If cement or other plugs were used, state the character of same and depth placed, from feet to feet for each plug set.

Bottom Plug at 600' with 50 sacks 50/50 Poz, 2% gel  
Middle Plug @ 300' with 25 sacks 50/50 Poz, 2% gel  
Top & bridge at 40' with 10 sacks 50/50 Poz 2% gel  
2 sacks in rathole

Job complete at 12:45 p.m. 11/2/77

RECEIVED  
STATE CORPORATION COMMISSION  
NOV 14 1977  
CONSERVATION DIVISION  
Wichita, Kansas

(If additional description is necessary, use BACK of this sheet)

Name of Plugging Contractor Slawson Drilling Company, Inc.


STATE OF Kansas COUNTY OF Sedgwick, ss.  
James C. Remsberg (employee of owner) or (owner or operator)  
of the above-described well, being first duly sworn on oath, says: That I have knowledge of the facts, statements, and matters herein contained and the log of the above-described well as filed and that the same are true and correct. So help me God.

(Signature) James C. Remsberg  
James C. Remsberg  
200 Douglas Building, Wichita, Kansas 67202  
(Address)

SUBSCRIBED AND SWORN TO before me this 10 day of November, 1977

Mary Lou Taylor  
Mary Lou Taylor Notary Public.

My commission expires January 17, 1981

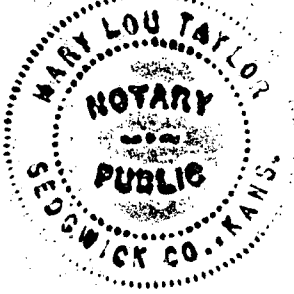

DRILLERS LOG

OPERATOR: Vincent Oil Corporation  
901 Union Center Building  
Wichita, Kansas 67202

LEASE: Schwien 'B' No. 1  
150' NE of NE NW Sec. 11-20S-22W  
Ness County, Kansas

CONTRACTOR: Slawson Drilling Company, Inc.  
200 Douglas Building  
Wichita, Kansas 67202

RTD: 4442'

COMMENCED: 10/25/77

COMPLETED: 11/2/77

CASING: 8-5/8" set at 490' with 300 sacks cement

0' to 495' Clay & Shale (495' 12 $\frac{1}{4}$ " Surface Hole)  
495' to 940' Shale & Shells with sand streaks  
940' to 1025' Sand  
1025' to 1494' Sand & Shale  
1494' to 1533' Anhydrite  
1533' to 1770' Shale  
1770' to 2155' Shale & Shells  
2155' to 2715' Shale & Lime  
2715' to 4255' Lime & Shale  
4255' to 4372' Lime  
4372' to 4372' Lime & Shale  
4372' Fort Scott  
4372' to 4381' Lime  
4381' to 4442' Cong & Miss  
4442' RTD

STATE OF KANSAS

COUNTY OF SEDGWICK

I, James C. Remsberg, of the Slawson Drilling Company, Inc.  
hereby state that the above and foregoing is a true and accurate copy of the  
Schwien 'B' No. 1 well for Vincent Oil Corporation.

*James C. Remsberg*  
James C. Remsberg

Subscribed and sworn to me this 10th day of November 1977.

*Mary Lou Taylor*  
Mary Lou Taylor, Notary

My commission expires January 17, 1981

RECEIVED  
STATE CORPORATION COMMISSION  
NOV 14 1977  
CONSERVATION DIVISION  
Wichita, Kansas

