


STATE OF KANSAS
STATE CORPORATION COMMISSION

WELL PLUGGING RECORD

Give All Information Completely
Make Required Affidavit
Mail or Deliver Report to:
Conservation Division
State Corporation Commission
212 No. Market
Wichita, Kansas

NESS County. Sec. 10 Twp. 20 Rge. (E) 22 (W)

Location as "NE/CNW/SW" or footage from lines. NE/4 NE/4
Lease Owner C-G DRILLING CO.
Lease Name STOECKLEIN Well No. 1
Office Address 1107 UNION NATIONAL BLDG.
Character of Well (completed as Oil, Gas or Dry Hole) DRY HOLE
Date well completed AUGUST 4 19 71
Application for plugging filed AUGUST 4 19 71
Application for plugging approved AUGUST 4 19 71
Plugging commenced AUGUST 4 19 71
Plugging completed AUGUST 4 19 71
Reason for abandonment of well or producing formation TOO LOW STRUCTURALLY

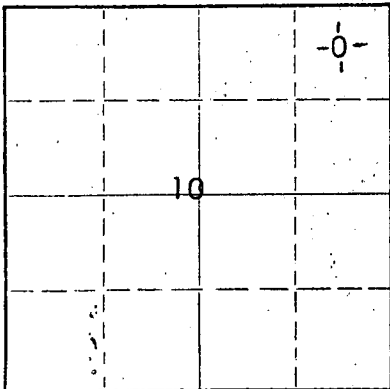

Locate well correctly on above Section Plat

If a producing well is abandoned, date of last production 19
Was permission obtained from the Conservation Division or its agents before plugging was commenced? YES

Name of Conservation Agent who supervised plugging of this well LEO F MASSEY, HAYS, KANSAS
Producing formation _____ Depth to top _____ Bottom _____ Total Depth of Well 4442 Feet
Show depth and thickness of all water, oil and gas formations.

OIL, GAS OR WATER RECORDS

CASING RECORD

FORMATION	CONTENT	FROM	TO	SIZE	PUT IN	PULLED OUT
				8 5/8"	351.42'	NONE

Describe in detail the manner in which the well was plugged, indicating where the mud fluid was placed and the method or methods used in introducing it into the hole. If cement or other plugs were used, state the character of same and depth placed, from _____ feet to _____ feet for each plug set.

FILLED WITH HEAVY MUD TO 550'. SET PLUG.
PUT IN 50 SACKS CEMENT. FILLED WITH HEAVY
MUD TO 240'. SET PLUG. PUT IN 25 SACKS
CEMENT. FILLED WITH HEAVY MUD UP TO 40'.
SET PLUG. FILLED TO TOP WITH 1 SACK HULLS
AND 10 SACKS CEMENT.

RECEIVED
STATE CORPORATION COMMISSION
AUG 17 1971
CONSERVATION DIVISION
Wichita, Kansas


(If additional description is necessary, use BACK of this sheet)

Name of Plugging Contractor C-G DRILLING CO.
Address 1107 UNION NATIONAL BUILDING, WICHITA, KANSAS 67202

STATE OF KANSAS, COUNTY OF SEDGWICK, ss.
G. F. GALLOWAY (employee of owner) or (owner or operator) of the above-described well, being first duly sworn on oath, says: That I have knowledge of the facts, statements, and matters herein contained and the log of the above-described well as filed and that the same are true and correct. So help me God

(Signature) *G. F. Galloway*
G. F. Galloway 1107 Union National Bldg.
(Address)

Subscribed and sworn to before me this 9th day of August, 19 71

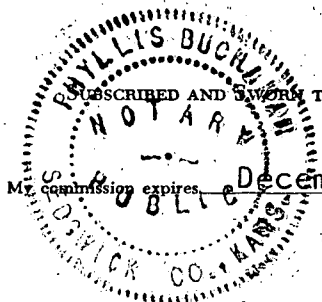

Phyllis Buchanan
Phyllis Buchanan Notary Public.

WELL LOG

15135-20462-0000

OPERATOR: C-G DRILLING CO.

WELL NAME: STOECKLEIN #1 LOCATION: NE/4 NE/4 SEC 10-20-22W

COUNTY: NESS STATE: KANSAS

WELL COMMENCED: JULY 25, 1971 WELL COMPLETED: AUGUST 3, 1971

ELEVATION: 2254 KB TOTAL DEPTH: 4442'

PRODUCTION: DRY & ABANDONED RIG NO: 1

CASING - 8-5/8": 10 JTS NEW 351.42' 8 5/8" W/200 SX QUICKSET

5-1/2":

ALL MEASUREMENTS TAKEN FROM THE TOP OF ROTARY BUSHING:

FROM	TO	FORMATION	DEVIATION FROM VERTICAL	REMARKS:
0	575	SHALE		
575	1000	SHALE & SAND		
1000	2255	SHALE & SHELLDS	1° 2065'	
2255	3820	LIME & SHALE		
3820	4420	LIME		
4420	4442	CHERT & SHALE		DST #1 4435'-4450'

RECEIVED
STATE CORPORATION COMMISSION
AUG 17 1971
CONSERVATION DIVISION
Wichita, Kansas

STATE OF KANSAS)
COUNTY OF SEDGWICK) SS:

The undersigned hereby certifies that to the best of his knowledge and belief, the above facts are true and correct.

C-G DRILLING CO.

By G. F. Galloway
G. F. Galloway

SUBSCRIBED AND SWORN TO, BEFORE ME, This 9th day of August, 1971.

NOTARY PUBLIC EXP. DEC. 7, 1971

Phyllis Buchanan
PHYLLIS BUCHANAN - NOTARY PUBLIC

