


STATE OF KANSAS
STATE CORPORATION COMMISSION

Give All Information Completely
Make Required Affidavit
Mail or Deliver Report to:
Conservation Division
State Corporation Commission
800 Bitting Building
Wichita, Kansas

WELL PLUGGING RECORD
OR
FORMATION PLUGGING RECORD

Strike out upper line
when reporting plug-
ging off formations.

NORTH

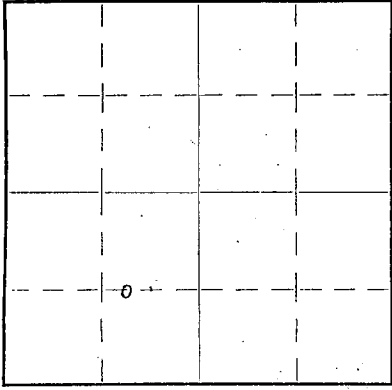

Locate well correctly on above
Section Plat

Barber County. Sec. 34 Twp. 30 Rge. (E) 14 (W)
Location as "NE 1/4 NW 1/4 SW 1/4" or footage from lines
Lease Owner ~~Fickens~~ Pryor & Lockhart Inc.
Lease Name Fickens Well No. 1
Office Address Wichita Kansas 820 Union Natl Bank Bldg.
Character of Well (Completed as Oil, Gas or Dry Hole) Dry
Date, well completed Jan 3rd, 1938
Application for plugging filed By Phone 1938
Application for plugging approved Yes. Jan 4th, 1938
Plugging Commenced Jan 6th, 1938
Plugging Completed Jan 10th, 1938
Reason for abandonment of well or producing formation Dry

If a producing well is abandoned, date of last production: 193
Was permission obtained from the Conservation Division or its agents before plugging was commenced?
Yes.

Name of Conservation Agent who supervised plugging of this well
Producing formation none. Depth to top. Bottom. Total Depth of Well 4665 Feet.
Show depth and thickness of all water, oil and gas formations.


OIL, GAS OR WATER RECORDS

CASING RECORD

Formation	Content	From	To	Size	Put In	Pulled Out
				13	720	None.
				10	1102	654

Describe in detail the manner in which the well was plugged, indicating where the mud fluid was placed and the method or methods used in introducing it into the hole. If cement or other plugs were used, state the character of same and depth placed, from feet to feet for each plug set.

Hole Filled with Hvy Rotary Mud from 4665 to 3380, Cement Plug from 3380 to 3180.
Hole filled with hvy. Rotary Mud form 3180 to 740. Hole Bridged at 200Ft. Fifteen
Cement Plug on Top of Bridge. Cement Plug from Top of Hole to Bottom of Cellar.

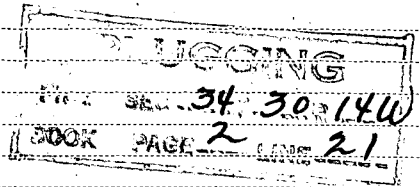

(If additional description is necessary, use BACK of this sheet)

Correspondence regarding this well should be addressed to Pryor & Lockart Inc.
Address 820 Union Natl Bank Bldg Wichita, Kansas.

STATE OF Kansas, COUNTY OF Sedgewick, ss.
T. P. Hendrick, (employee of owner) of the above-described well,
being first duly sworn on oath, says: That I have knowledge of the facts, statements, and matters herein contained and the log of the above-described well as filed and that the same are true and correct. So help me God.

(Signature) T. P. Hendrick
820 Union Natl Bank Wichita (Address)

SUBSCRIBED AND SWORN TO before me this 18th day of June, 1938.
My commission expires 5, 1938

(Signature) Notary Public.

WELL LOG BUREAU - KANSAS GEOLOGICAL SOCIETY.
412 Union National Bk Bldg, Wichita, Kansas.


PRYOR & LOCKHART, INC.
Pickens No. 1

5-007-10140-0000

SEC. 34 T. 30 R. 14W.
CWL E 1/2 SW

Total Depth. 4745
Comm. 11-7-37 Comp. 1-3-38
Shot or Treated.
Contractor. Patton Drlg. Co.
Issued. 1-15-38

County Barber.

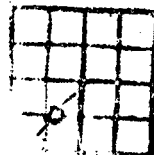

CASING.

13" 720'
10" 1102'

Elevation.

Production. DRY.

Figures Indicate Bottom of Formations.

surface	50	Top Topoka lime	3005
sand	190	Top Lansing KC	3857
red rock	675	Top Chat	4341
sand	685	Top Kinderhook shale	4405
red rock	720	Top Mazon sand	4419
lime	760	Top Viola lime	4420
shale	1109	Top Simpson shale	4565
shale and shells	1500	Top Simpson sand	4578
shale	1900	Top Arbuckle lime	4665
shale and shells	1950		
shale	2197		
sand	2265		
lime	2405		
shale and shells	2455		
lime	2640		
lime and shells	2760		
lime	2930		
lime and shale	3060		
lime	3285		
lime soft	3345		
lime	3395		
shale	3450		
lime	3670		
lime and shale	3705		
shale	3750		
sand and shale	3780		
sand and lime	3790		
shale and lime	3805		
shale	3830		
shale and gas sand	3845		
sand	3870		
shale and lime	3875		
lime	4160		
shale	4170		
sdv lime	4185		
lime	4270		
broken lime	4295		
lime	4305		
shale and lime	4341		
chat	4358		
lime and shale	4380		
chat and lime	4396		
shale and lime	4420		
lime	4570		
shale	4575		
shale and sand	4585		
sand	4615		
lime	4635		
sand and shale	4670		
lime	4745		
Total Depth.			