


WELL PLUGGING RECORD

Give All Information Completely
Make Required Affidavit
Mail or Deliver Report to:
Conservation Division
State Corporation Commission
211 No. Broadway
Wichita, Kansas

Ness County. Sec. 25 Twp. 19 Rge. 22 (E) W (W)

NORTH

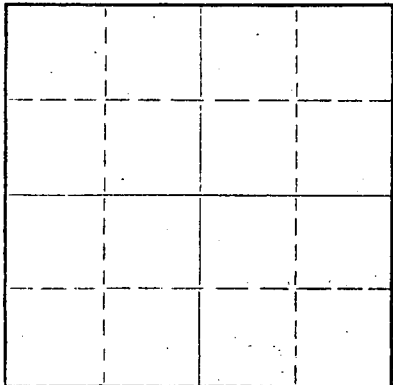

Locate well correctly on above
Section Plat

Location as "NE/CNW/SW" or footage from lines C NW SW
Lease Owner Sinclair Oil & Gas Company
Lease Name Dora Wagner Well No. 2
Office Address Great Bend, Kansas
Character of Well (completed as Oil, Gas or Dry Hole) _____
Date well completed _____ 19____
Application for plugging filed _____ 19____
Application for plugging approved _____ 19____
Plugging commenced 6-22-66 _____ 19____
Plugging completed 6-24-66 _____ 19____
Reason for abandonment of well or producing formation Depleted.

If a producing well is abandoned, date of last production _____ 19____
Was permission obtained from the Conservation Division or its agents before plugging was commenced? yes

Name of Conservation Agent who supervised plugging of this well Massey
Producing formation _____ Depth to top _____ Bottom _____ Total Depth of Well 4405 Feet
Show depth and thickness of all water, oil and gas formations.

OIL, GAS OR WATER RECORDS

CASING RECORD

FORMATION	CONTENT	FROM	TO	SIZE	PUT IN	PULLED OUT
				8-5/8"	1483'	None
				5-1/2"	4404'	3476'

Describe in detail the manner in which the well was plugged, indicating where the mud fluid was placed and the method or methods used in introducing it into the hole. If cement or other plugs were used, state the character of same and depth placed, from _____ feet to _____ feet for each plug set.

Checked hole to plug back @ 4389', sanded hole to 4370'
and dumped 5 sacks of cement @ 4370' with dump bailer.
Pulled 5 1/2" casing, set rock bridge @ 500' and dumped 25
sacks of cement. Mudded hole to 40', set rock bridge to
30' and ran 10 sacks of cement to base of cellar.

RECEIVED
STATE CORPORATION COMMISSION
JUL 5 1966
7-5-66
CONSERVATION DIVISION
WICHITA, KANSAS

PLUGGING COMPLETE.

Name of Plugging Contractor KNIGHT CASING PULLING COMPANY
Address CHASE, KANSAS

STATE OF KANSAS, COUNTY OF RICE, ss. Noel J. Knight

(employee of owner) or owner/executor of the above-described well, being first duly sworn on oath, says: That I have knowledge of the facts, statements, and matters herein contained and the log of the above-described well as filed and that the same are true and correct. So help me God.

(Signature) Noel J. Knight
Chase, Kansas
(Address)

SUBSCRIBED AND SWORN TO before me this 28th day of June, 19 66

Milton J. Volin
Notary Public.

GABBERT-JONES INC.
WICHITA, KANSAS
DRILLER'S WELL LOG

BORA WAGNER #2
 C NW SW SECTION 25-19S-22W
 NEBB COUNTY, KANSAS

COMMENCED: FEBRUARY 28, 1964
 COMPLETED: MARCH 15, 1964

15-135-19017-0000

OPERATOR - SINCLAIR OIL & GAS CO.

DEPTH		FORMATION	REMARKS
FROM	TO		
0	275	CLAY, SAND & SHALE	
275	500	SHALE & RED ROCK	
500	730	SHALE, SHELLS & RED BED	
730	1215	SHALE, SAND & RED BED	
1215	1435	SHALE & SHELLS	
1435	1460	RED BED	
1460	1590	ANHYDRITE	RAN 47 JOINTS 8-5/8" CASING, SET @ 1483° w/ 700 BAGGS CEMENT.
1590	1710	SANDY SHALE	
1710	2130	SHALE	
2130	2467	SHALE & LIME	
2467	3600	LIME	
3600	2630	LIME & SHALE	
2630	2900	LIME	
2900	3275	LIME & SHALE	
3275	3425	SHALE	
3425	3815	SHALE & LIME	
3815	4405	LIME	
4405	TD		RAN 137 JOINTS 5-1/2" CASING, SET @ 4404° w/ 150 BAGGS CEMENT

I, E. E. HALL, CERTIFY THIS IS A CORRECT COPY OF THE DRILLER'S LOG FOR THE WELL
 DRILLED IN C NW SW SECTION 25-19S-22W, NEBB COUNTY, (KANSAS), TO THE BEST OF MY KNOWLEDGE
 AND BELIEF.

E. E. HALL
 E. E. HALL

STATE OF KANSAS)
) SS
 COUNTY OF SEDGWICK)

BEFORE ME THE UNDERSIGNED, A NOTARY PUBLIC WITHIN AND FOR SAID COUNTY AND STATE,
 ON THIS 16TH DAY OF MARCH, 1964, PERSONALLY APPEARED E. E. HALL TO ME PERSONALLY KNOWN
 TO BE THE IDENTICAL PERSON WHO EXECUTED THE WITHIN AND FOREGOING INSTRUMENT AND
 ACKNOWLEDGED TO ME THAT HE EXECUTED THE SAME AS HIS FREE AND VOLUNTARY ACT AND DEED FOR
 THE USES AND PURPOSES THEREIN SET FORTH.

IN WITNESS WHEREOF, I HAVE HEREUNTO SET MY HAND AND OFFICIAL SEAL THE DAY AND YEAR
 LAST ABOVE WRITTEN.

VIRA A. MCKENZIE, NOTARY PUBLIC

My Commission Expires October 2, 1967

RECEIVED
 STATE CORPORATION COMMISSION

JUN -2 1966

CONSERVATION DIVISION
 Wichita, Kansas