


STATE OF KANSAS
STATE CORPORATION COMMISSION

Give All Information Completely
Make Required Affidavit
Mail or Deliver Report to:
Conservation Division
State Corporation Commission
211 No. Broadway
Wichita, Kansas

WELL PLUGGING RECORD

NORTH

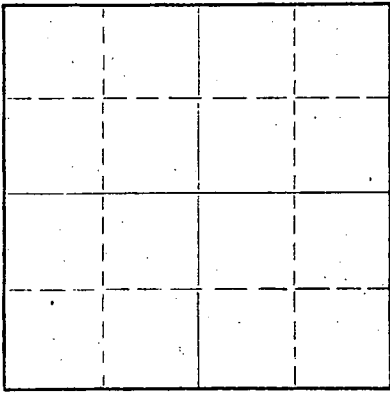

Locate well correctly on above
Section Plat

Barber County. Sec. 25 Twp. 32 Rge. 13W (E) (W)
Location as "NE/CNW/SW" or footage from lines NE NE NE
Lease Owner Santa Fe Pipe & Supply
Lease Name Lonker Well No. 1
Office Address Box 562, Great Bend, Kansas
Character of Well (completed as Oil, Gas or Dry Hole) Oil
Date well completed _____ 19____
Application for plugging filed _____ 19____
Application for plugging approved _____ 19____
Plugging commenced January 14 19 62
Plugging completed January 23 19 62
Reason for abandonment of well or producing formation Depleted

If a producing well is abandoned, date of last production _____ 19____
Was permission obtained from the Conservation Division or its agents before plugging was commenced? yes

Name of Conservation Agent who supervised plugging of this well Mr. Hampel
Producing formation _____ Depth to top _____ Bottom _____ Total Depth of Well 4519 Feet
Show depth and thickness of all water, oil and gas formations.

OIL, GAS OR WATER RECORDS

CASING RECORD

FORMATION	CONTENT	FROM	TO	SIZE	PUT IN	PULLED OUT
<u>5</u>				<u>8 5/8</u>	<u>321</u>	
				<u>5 1/2</u>	<u>4556</u>	

Describe in detail the manner in which the well was plugged, indicating where the mud fluid was placed and the method or methods used in introducing it into the hole. If cement or other plugs were used, state the character of same and depth placed, from _____ feet to _____ feet for each plug set.

Filled hole with sand to 1450' dumped 5 sacks cement
Pipe to 31" tension
Shot pipe 3908' and 3815'
Bailed hole to 250' set 10' rock bridge mixed 25 sacks cement
Filled hle with mud to 30' mixed 10 sacks cap on well.

RECEIVED
STATE CORPORATION COMMISSION
MAR 29 1962
CONSERVATION DIVISION
Wichita, Kansas

(If additional description is necessary, use BACK of this sheet)

Name of Plugging Contractor Pipe Pullers, Inc.
Address Box 486, Ellinwood, Kansas

STATE OF Kansas, COUNTY OF Barton, ss.
Pipe Pullers, Inc. (employee of owner) or (owner or operator) of the above-described well, being first duly sworn on oath, says: That I have knowledge of the facts, statements, and matters herein contained and the log of the above-described well as filed and that the same are true and correct. So help me God.

(Signature) [Signature]
Box 486, Ellinwood, Kansas
(Address)

SUBSCRIBED AND SWORN to before me this 26 day of January, 1962

My commission expires December 18, 1962

[Signature]
Notary Public.

WELL LOG BUREAU—KANSAS GEOLOGICAL SOCIETY
508 East Murdock, Wichita, Kansas


COPY

Company: FRED B. ANSCHUTZ
Farm: Lonker No. 1

SEC. 25 T. 32 R. 13W
NE NE NE

Total Depth. 4971'
Comm. 9-28-54 Date 10-25-54
Shot or Treated.
Contractor.
Issued. 3-31-56

County Barber
KANSAS

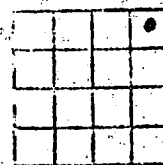

Elevation. 1655'

Production. 161 BO

CASING:

8 5/8" 321' cem w/225 sx
5 1/2" 4556' cem w/100 sx

Figures indicate Bottom of Formations.

surface clay	35
red bed & shale	145
sand	160
red bed	590
red bed & shale	1100
shale & shells	1550
shale & lime	1715
lime	2205
lime & shale	2325
lime & shale	2400
shale & lime	2730
lime & shale	2960
lime	3115
shale & lime	3210
lime	3430
lime & shale	3490
shale & lime	3756
lime	3836
shale & lime	3896
lime	4456
lime & chert	4542
lime & shale	4601
shale & lime	4609
lime & shale	4631
lime	4645
lime & shale	4747
lime	4844
lime & shale	4856
shale & sand	4875
sand & shale	4879
sand & lime	4903
sand & shale	4954
Arbuckle	4971 RTD
Total Depth	

Tops: Scout	
Elgin	3621
Heebner	3722
Douglas	3794
Lansing	3896
Mississippi	4457
Viola	4745
Arbuckle	4954

RECEIVED
STATE CORPORATION COMMISSION
MAR 29 1962
CONSERVATION DIVISION
Wichita, Kansas