


STATE OF KANSAS
STATE CORPORATION COMMISSION

WELL PLUGGING RECORD

Give All Information Completely
Make Required Affidavit
Mail or Deliver Report to
Conservation Division
State Corporation Comm.
245 North Water
Wichita, KS 67202

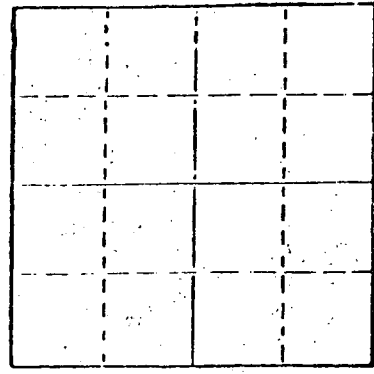

Locate well correctly on above
Section Plat

Ness County. Sec. 22 Twp. 19S Rge. 22 E/W
Location as "NE/CNW $\frac{1}{4}$ SW $\frac{1}{4}$ " or footage from lines
C W/2 SE SW
Lease Owner Twin Western Resources, Inc.
Lease Name Foos Well No. 1
Office Address 920 Union Center, Wichita, Ks. 67202
Character of Well (Completed as Oil, Gas or Dry Hole) dry hole

Date Well completed 2-26 1980
Application for plugging filed 2-26 1980
Application for plugging approved 2-26 1980
Plugging commenced 2-26 1980
Plugging completed 2-26 1980
Reason for abandonment of well or producing formation
no commercial quantities of oil or gas encountered
If a producing well is abandoned, date of last production -- 19

Was permission obtained from the Conservation Division or
its agents before plugging was commenced? yes

Name of Conservation Agent who supervised plugging of this well Marion Schmidt
Producing formation Depth to top Bottom Total Depth of Well 4378
Show depth and thickness of all water, oil and gas formations.

OIL, GAS OR WATER RECORDS


CASING RECORD

FORMATION	CONTENT	FROM	TO	SIZE	PUT IN	PULLED OUT
surface hole	shale	surf	513'	8-5/8	505	none

Describe in detail the manner in which the well was plugged, indicating where the mud fluid
was placed and the method or methods used in introducing it into the hold. If cement or other
plugs were used, state the character of same and depth placed, from feet to
feet for each plug set.

Fluid to 720', plug, 70 sx
Fluid to 480', plug, 20 sx
Fluid to 40', plug, 10 sx
Rat hole 5 sx

(If additional description is necessary, use BACK of this sheet)
Name of Plugging Contractor D N B DRILLING, INC.
515 R. H. Garvey Building
Wichita, Kansas 67202

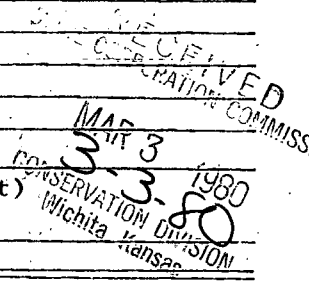


STATE OF Kansas COUNTY OF Sedgwick, ss.
Ella Priess (employee of owner) or (owner or operator)
of the above-described well, being first duly sworn on oath, says: That I have knowledge of
the facts, statements, and matters herein contained and the log of the above-described well
as filed and that the same are true and correct. So help me God.

(Signature) Ella Priess
515 R.H. Garvey Bldg., Wichita, Ks. 67202
(Address)

SUBSCRIBED AND SWORN TO before me this 28th day of February, 19 80

My commission expires April 30, 1983

Dorothy L. Schmidt
Dorothy L. Schmidt Notary Public.

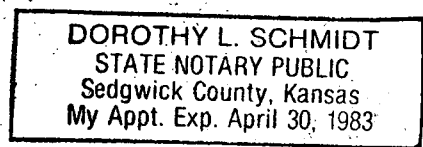

15.135 21751 0000

DRILLERS' LOG

TWIN WESTERN RESOURCES, INC.

Foos No. 1
C W/2 SE SW
Sec. 22-19S-22W
Ness Co., Ks.

Commenced: 2-16-80
Completed: 2-26-80

Surface Casing: 505' of 8-5/8"
cemented w/275 sx common, 2% gel,
3% cc

FORMATION

DEPTH

Surface Hole	0 - 513
Shale, Sand & Red Bed	513 - 1240
Shale & Lime	1240 - 1852
Lime & Shale	1852 - 3995
Lime	3995 - 4378 RTD

I do hereby certify that the foregoing statements are true and correct to the best of my knowledge and belief.

D N B DRILLING, INC.

Ella Priess

Ella Priess

STATE OF KANSAS: ss:

Subscribed and sworn to before me this 28th day of February, 1980.

Dorothy L. Schmidt

Dorothy L. Schmidt, Notary Public

