

STATE OF KANSAS
STATE CORPORATION COMMISSION

WELL PLUGGING RECORD

Give All Information Completely
Make Required Affidavit
Mail or Deliver Report to
Conservation Division
State Corporation Comm.
245 North Water
Wichita, KS 67202

Ness County, Sec. 22 Twp. 19S Rge. 22W E/W
Location as "NE/CNW 1/4 SW 1/4" or footage from lines
NE NW

Lease Owner Mack Oil Co.
Lease Name FRANKLIN FOOS Well No. 2


Office Address Box 400, Duncan, Oklahoma 73533
Character of Well (Completed as Oil, Gas or Dry Hole)
Dry Hole

Date Well completed 3-11 1977
Application for plugging filed (Verbally) 3-11 1977
Application for plugging approved (Verbally) 3-11 1977
Plugging commenced 3-11 1977
Plugging completed 3-11 1977

Reason for abandonment of well or producing formation
No commercial quantity of oil or gas encountered
If a producing well is abandoned, date of last production 19

Was permission obtained from the Conservation Division or
its agents before plugging was commenced? Yes

Name of Conservation Agent who supervised plugging of this well
Producing formation Depth to top Bottom Total Depth of Well
Show depth and thickness of all water, oil and gas formations.

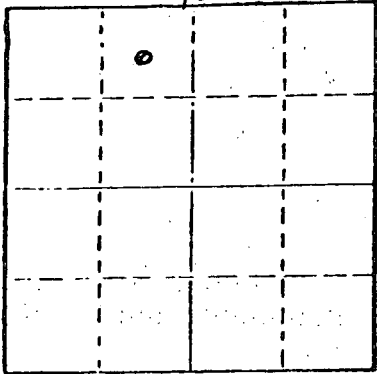

Locate well correctly on above
Section Plat

OIL, GAS OR WATER RECORDS

CASING RECORD

FORMATION	CONTENT	FROM	TO	SIZE	PUT IN	PULLED OUT

Describe in detail the manner in which the well was plugged, indicating where the mud fluid was placed and the method or methods used in introducing it into the hold. If cement or other plugs were used, state the character of same and depth placed, from feet to feet for each plug set.

T.D. 4498',
Set 1st plug at 550' with 50 sx.
set 2nd plug at 240' with 25 sx.
3rd plug at 40' with 10 sx.

Plug was down at 2:30 a.m. 3-11-77.

RECEIVED
STATE CORPORATION COMMISSION

MAR 17 1977

CONSERVATION DIVISION
Wichita, Kansas

(If additional description is necessary, use BACK of this sheet)

Name of Plugging Contractor Abercrombie Drilling, Inc.

STATE OF Kansas COUNTY OF Sedgwick ss.
Jack L. Partridge, Asst. Sec.-Treas. (employee of owner) or (owner or operator) of the above-described well, being first duly sworn on oath, says: That I have knowledge of the facts, statements, and matters herein contained and the log of the above-described well as filed and that the same are true and correct. So help me God.

(Signature) *Jack L. Partridge*
801 Union Center, Wichita, Kansas 67202 (Address)

Subscribed and sworn to before me this 14th day of March 1977

My commission expires

Kathy S. Goertz
Kathy S. Goertz Notary Public.



CONTRACTOR'S WELL LOG

15-135-21291-0000

OPERATOR: Mack Oil Co.
 CONTRACTOR: Abercrombie Drilling, Inc.
 WELL NAME: FRANKLIN FOOS #2
 LOCATION: NE NW, Section 22-19S-22W
 Ness County, Kansas
 SPUD DATE: 3-01-77
 COMPLETION DATE: 3-11-77

0	370	Surface Clay & Sand
370	1480	Sand & Shale
1480	1516	Anhydrite
1516	1575	Sand & Shale
1575	1945	Shale
1945	2362	Sand & Shale
2362	2773	Shale & Lime
2773	2968	Sand & Shale
2968	3140	Shale & Sand
3140	4245	Shale & Lime
4245	4267	Lime
4267	4329	Shale & Lime
4329	4366	Lime
4366	4387	Shale & Lime
4387	4498	Lime
	4498	Rotary Total Depth

Spud hole at 8:40 p.m. 3-01-77. Drilled 370' of 12 1/4" hole. Ran 9 jts. of 8 5/8" surface casing. (Tally 359.80') Set at 365.67' K.B. Cemented with 250 sx. common cement, 3% Ca. Cl. 2% gel. Plug was down at 9:30 a.m. 3-02-77. Cement did circulate.

T.D. 4498', Set 1st plug at 550' with 50 sx., 2nd plug at 240' with 25 sx., 3rd plug at 40' with 10 sx. Plug was down at 2:30 a.m. 3-11-77.

SAMPLE TOPS:

Anhydrite 1480' (+731)
 B/Anhydrite 1516' (+695)

RECEIVED
 STATE CORPORATION COMMISSION

MAR 17 1977

STATE OF KANSAS)
) SS
 COUNTY OF SEDGWICK)

CONSERVATION DIVISION
 Wichita, Kansas

Jack L. Partridge, Assistant Secretary-Treasurer of Abercrombie Drilling, Inc., does hereby state that the above and foregoing is a true and correct log of the FRANKLIN FOOS #2, NE NW Section 22-19S-22W, Ness County, Kansas.

ABERCROMBIE DRILLING, INC.

BY: Jack L. Partridge
 Jack L. Partridge, Asst. Sec.-Treas.

Subscribed and sworn to before me, a Notary Public, in and for the aforesaid county and state as of this 14th day of March, 1977.

Kathy S. Goertz
 Kathy S. Goertz, Notary Public

