

STATE OF KANSAS  
STATE CORPORATION COMMISSION


WELL PLUGGING RECORD

Give All Information Completely  
Make Required Affidavit  
Mail or Deliver Report to  
Conservation Division  
State Corporation Comm.  
245 North Water  
Wichita, KS 67202

Ness County. Sec. 22 Twp. 19S Rge. 22W E/W  
Location as "NE/CNW $\frac{1}{4}$ /SW $\frac{1}{4}$ " or footage from lines  
C SW NE

Lease Owner MACK OIL CO.  
Lease Name Rahm Well No. 2

Office Address P. O. Box 400, Duncan, Okla. 73533  
Character of Well (Completed as Oil, Gas or Dry Hole) Dry Hole

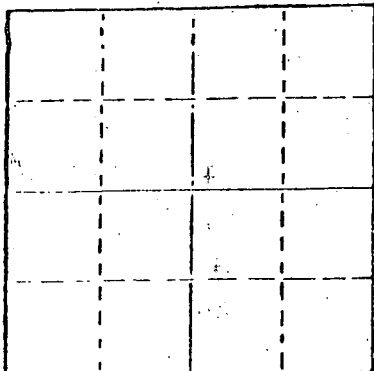

Locate well correctly on above  
Section Plat

Date Well completed 7-23-1976  
Application for plugging filed 7-23-1976  
Application for plugging approved 7-23-1976  
Plugging commenced 7-23-1976  
Plugging completed 7-23-1976

Reason for abandonment of well or producing formation  
No commercial quantities of oil or gas encountered  
If a producing well is abandoned, date of last production  
19

Was permission obtained from the Conservation Division or  
its agents before plugging was commenced? Yes

Name of Conservation Agent who supervised plugging of this well Leo Massey  
Producing formation \_\_\_\_\_ Depth to top \_\_\_\_\_ Bottom \_\_\_\_\_ Total Depth of Well 4420  
Show depth and thickness of all water, oil and gas formations.

OIL, GAS OR WATER RECORDS

CASING RECORD

FORMATION	CONTENT	FROM	TO	SIZE	PUT IN	PULLED OUT
Surface Hole	Shale	Surf.	361	8-5/8 <del>8 1/2</del>	353	None

Describe in detail the manner in which the well was plugged, indicating where the mud fluid was placed and the method or methods used in introducing it into the hold. If cement or other plugs were used, state the character of same and depth placed, from \_\_\_\_\_ feet to \_\_\_\_\_ feet for each plug set.

RECEIVED  
STATE CORPORATION COMMISSION  
AUG 2 1976  
8-2-76  
CONSERVATION DIVISION  
Wichita, Kansas

Fluid to 550', plug, 50 sx cement;  
Fluid to 300', plug, 25 sx cement;  
Fluid to 40', plug, 1/2 sx hulls, 10sx cement..

(If additional description is necessary, use BACK of this sheet)

Name of Plugging Contractor D N B DRILLING, INC.  
701 First National Building  
Wichita, Kansas 67202

STATE OF KANSAS COUNTY OF \_\_\_\_\_, ss.  
JAMES L. DONELSON (employee of owner) or (owner or operator)  
of the above-described well, being first duly sworn on oath, says: That I have knowledge of  
the facts, statements, and matters herein contained and the log of the above-described well  
as filed and that the same are true and correct. So help me God.

(Signature) James L. Donelson  
701 First Nat'l Bank Bldg.,  
(Address)

SUBSCRIBED AND SWORN TO before me this 29th day of July, 19 76

Ella Priess  
Notary Public.

My commission expires 8-25-76

Ella Priess

Ella Priess  
STATE NOTARY PUBLIC  
Sedgwick County, Kansas  
My Com. Expires Aug. 25, 1976

DRILLERS' LOG

JS 135-21228-0000

MACK OIL CO.  
No. 2 Rahm  
C SW NE, Sec. 22-18-22W  
Ness County, Kansas

Elev: 2204 G.L.

Commenced: 7-17-76  
Completed: 7-23-76

Surface Casing: 353' of 8-5/8"  
cemented w/225 sx common  
cement, 2% Gel, 3% cc.  
7-17-76

FORMATION

DEPTH

Surface Hole	0 - 361
Shale	361 - 1127
Blaine Anhydrite	1127 - 1135
Shale & Sand	1135 - 1345
Shale & Red Bed	1345 - 1468
Anhydrite	1468 - 1505
Shale	1505 - 2305
Shale w/ lime	2305 - 2485
Lime & Shale	2485 - 2710
Lime & Shale	2710 - 3705
Lime	3705 - 4420 RTD

I do hereby certify that the foregoing statements are true and correct to the best of my knowledge and belief.

D N B DRILLING, INC.

*James L. Donelson*  
JAMES L. DONELSON

STATE OF KANSAS: ss:

Subscribed and sworn to before me this 29th day of July, 1976.

*Ella Priess*  
Ella Priess, Notary Public

*Ella Priess*  
STATE NOTARY PUBLIC  
Sedgwick County, Kansas  
My Com. Expires Aug. 25, 1976