


STATE OF KANSAS
STATE CORPORATION COMMISSION
CONSERVATION DIVISION
P. O. BOX 17027
WICHITA, KANSAS 67217

FORM CP-4

WELL PLUGGING RECORD

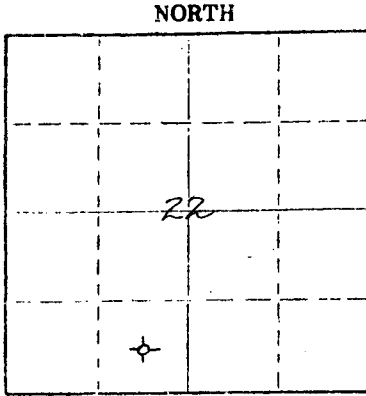

Locate well correctly on above Section Plat

Ness County, Sec 22 Twp 19S Rge 22 W (W)
Location as "NE/CNW/SE/SW" or footage from lines. C SE SW
Lease Owner Mack Oil Co.
Lease Name Foos Well No. 1
Office Address 812 Union Center Bldg., Wichita, KS 67202
Character of Well (completed as Oil, Gas or Dry Hole) Dry hole
Date well completed 5-22-75 19
Application for plugging filed 5-21-75 19
Application for plugging approved 5-21-75 19
Plugging commenced 5-21-75 19
Plugging completed 5-22-75 19
Reason for abandonment of well or producing formation commercial quantities of oil not found
If a producing well is abandoned, date of last production 19
Was permission obtained from the Conservation Division or its agents before plugging was commenced? yes

Name of Conservation Agent who supervised plugging of this well Leo Massey-Hays, KS
Producing formation _____ Depth to top _____ Bottom _____ Total Depth of Well 4400 Feet
Show depth and thickness of all water, oil and gas formations.

OIL, GAS OR WATER RECORDS

CASING RECORD

FORMATION	CONTENT	FROM	TO	SIZE	PUT IN	PULLED OUT
				8-5/8"	346'	

Describe in detail the manner in which the well was plugged, indicating where the mud fluid was placed and the method or methods used in introducing it into the hole. If cement or other plugs were used, state the character of same and depth placed, from _____ feet to _____ feet for each plug set.

Plug @ 600' w/70 sx
300' w/20 sx
40' w/10 sx & bridge

RECEIVED
STATE CORPORATION COMMISSION
MAY 28 1975
CONSERVATION DIVISION
Wichita, Kansas

(If additional description is necessary, use BACK of this sheet)

Name of Plugging Contractor Rains & Williamson Oil Co., Inc.
Address 435 Page Court, 220 W. Douglas, Wichita, KS 67202

STATE OF Kansas COUNTY OF Sedgwick ss.
Wilson Rains, President (employee of owner) or (owner or operator) of the above-described

well, being first duly sworn on oath, says: That I have knowledge of the facts, statements, and matters herein contained and the log of the above-described well as filed and that the same are true and correct. So help me God.

(Signature) Wilson Rains Wilson Rains

435 Page Court, 220 W. Douglas, Wichita, KS 67202 (Address)

SUBSCRIBED AND SWORN TO before me this 23rd day of May 1975

My commission expires October 4, 1975



Juanita M. Green
Notary Public.

WELL LOG

15-135-2052-0000

COMPANY Mack Oil Co.

SEC. 22 T. 19S R. 22W

LOC. C SE SW

FARM FOOS

NO. 1


RIG. NO. 7

TOTAL DEPTH 4400'5

COMM. 5-9-75

COMP. 5-22-75

COUNTY NESS, KANSAS

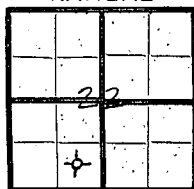

CONTRACTOR Rains & Williamson Oil Co., Inc.

CASING

20	10		
15		8-5/8" @ 346' w/225' sx common, 2% gel	ELEVATION 2218 KB
12	6		3% cc
13	5		PRODUCTION D&A

FIGURES INDICATE BOTTOM OF FORMATIONS

Tophole Soil	20
Rock & Shale	75
Shale & Post Rock	3346
Shale	940
Sand	1140
Shale	1482
Anhydrite	1517
Shale	2280
Shale & Lime	3227
Lime & Shale	3595
Shale & Lime	3780
Lime & Shale	4020
Lime	4308
Lime & Shale	4350
Mississippi	4400
<u>Rotary Total Depth</u>	<u>4400</u>

RECEIVED
STATE CORPORATION COMMISSION
MAY 28 1975
CONSERVATION DIVISION
Wichita, Kansas

State of Kansas
County of Sedgwick } ss:

Wilson Rains, President of the Rains & Williamson Oil Co. Company, Inc.

upon oath state that the above and foregoing is a true and correct copy of the log of the Foos #1 well.

Wilson Rains
Wilson Rains

scribed and sworn to before me this 23rd day of May 19 75

ommission Expires: October 4, 1975

Juanita M. Green
NOTARY PUBLIC
Juanita M. Green

