


STATE OF KANSAS
STATE CORPORATION COMMISSION

WELL PLUGGING RECORD

Give All Information Completely
Make Required Affidavit
Mail or Deliver Report to
Conservation Division
State Corporation Comm.
245 North Water
Wichita, KS 67202

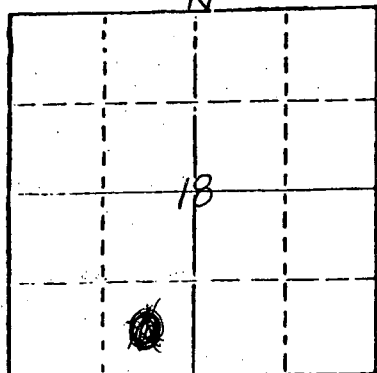

Locate well correctly on above
Section Plat

Ness County, Sec. 18 Twp. 19S Rge. 22 E/W
Location as "NE/CNW 1/4 SW 1/4" or footage from lines
C SE SW

Lease Owner K & E Petroleum, Inc.

Lease Name Schlegel Well No. 1

Office Address 816 Union Center, Wichita, Ks. 67202

Character of Well (Completed as Oil, Gas or Dry Hole)
Dry Hole

Date Well completed Oct. 7 1977

Application for plugging filed (verbally) Oct. 7 1977

Application for plugging approved (verbally) Oct. 7 1977

Plugging commenced Oct. 7 1977

Plugging completed Oct. 7 1977

Reason for abandonment of well or producing formation

No commercial quantity of oil or gas encountered

If a producing well is abandoned, date of last production
19

Was permission obtained from the Conservation Division or
its agents before plugging was commenced? Yes

Name of Conservation Agent who supervised plugging of this well Leo Massey

Producing formation Depth to top Bottom Total Depth of Well 4361'

Show depth and thickness of all water, oil and gas formations.

OIL, GAS OR WATER RECORDS

CASING RECORD

FORMATION	CONTENT	FROM	TO	SIZE	PUT IN	PULLED OUT

Describe in detail the manner in which the well was plugged, indicating where the mud fluid was placed and the method or methods used in introducing it into the hold. If cement or other plugs were used, state the character of same and depth placed, from feet to feet for each plug set.

Set 1st plug at 600' with 50 sacks

2nd plug at 300' with 25 sacks

40' solid bridge with 10 sacks

Cemented with 50/50 posmix, 6% gel

Plug was down at 10:30 a.m., October 7, 1977.

10-13-77
NOTARY PUBLIC
WICHITA, KANSAS

(If additional description is necessary, use BACK of this sheet)

Name of Plugging Contractor Abercrombie Drilling, Inc.

STATE OF Kansas COUNTY OF Sedgwick, ss.

Jack L. Partridge, Ass't. Secretary-Treasurer (employee of owner) or (owner or operator) of the above-described well, being first duly sworn on oath, says: That I have knowledge of the facts, statements, and matters herein contained and the log of the above-described well as filed and that the same are true and correct. So help me God.

(Signature)

801 Union Center, Wichita, Kansas 67202

(Address)

SUBSCRIBED AND SWORN TO before me this 11th day of October, 1977

PUBLIC

Sandra Richman

Notary Public.

My commission expires July 21, 1979

OPERATOR: K & E Petroleum, Inc.
CONTRACTOR: Abercrombie Drilling, Inc.
WELL NAME: Schlegel #1
LOCATION: C SE SW Section 18-19S-22W
Ness County, Kansas
SPUD DATE: September 28, 1977
COMPLETION DATE: October 7, 1977

0	132	Shale & sand
132	522	Sand & shale
522	929	Shale & sand
929	1143	Sand
1143	1488	Shale
1488	1513	Anhydrite
1513	2075	Shale & sand
2075	2445	Sand & shale
2445	3112	Shale
3112	3363	Shale & lime
3363	3862	Shale
3862	4361	Lime
	4361	Rotary Total Depth

Spud hole at 8:15 p.m., September 28, 1977. Drilled 505' of 12 $\frac{1}{4}$ " hole. Ran 13 joints of 28# - 8-5/8" surface casing. Set at 500' K.B. Cemented with 275 sacks of common cement, 2% gel, 3% CaCl. Cement did circulate. Plug was down at 10:00 a.m., September 29, 1977.

T. D. 4361'. Set 1st plug at 600' with 50 sacks, 2nd plug at 300' with 25 sacks, 40' solid bridge with 10 sacks. Cemented with 50/50 posmix, 6% gel. Plug was down at 10:30 a.m., October 7, 1977.

SAMPLE TOPS:

Anhydrite 1488' (+730)
B/Anydrite 1513' (+705)

OCT 13 1977

CONSERVATION DIVISION
STATE OF KANSAS

STATE OF KANSAS)
COUNTY OF SEDGWICK) ss


Jack L. Partridge, Assistant Secretary-Treasurer of Abercrombie Drilling, Inc., does hereby state that the above and foregoing is a true and correct copy of the log of the Schlegel #1, C SE SW Section 18-19S-22W, Ness County, Kansas.

ABERCROMBIE DRILLING, INC.

BY Jack L. Partridge
Jack L. Partridge,
Assistant Secretary-Treasurer

Subscribed and sworn to before me, a Notary Public, in and for the aforesaid county and state as of this 11th day of October, 1977.

Sandra Richman
Sandra Richman, Notary Public

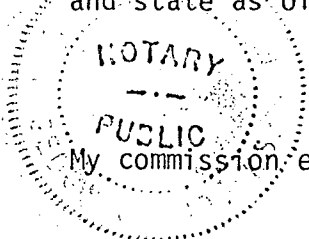

My commission expires July 21, 1979.