


STATE OF KANSAS
STATE CORPORATION COMMISSION

WELL PLUGGING RECORD

Give All Information Completely
Make Required Affidavit
Mail or Deliver Report to:
Conservation Division
State Corporation Commission
212 No. Market
Wichita, Kansas

Ness County. Sec. 7 Twp. 20S Rge. 22W (XX) (W)
Location as "NE/CNW/SW" or footage from lines C NE SW
Lease Owner D. R. Lauck Oil Company, Inc.
Lease Name McCreight Well No. 1
Office Address 301 S. Broadway, Wichita, Kansas
Character of Well (completed as Oil, Gas or Dry Hole) Dry Hole
Date well completed April 12, 1968
Application for plugging filed April 12, 1968
Application for plugging approved April 12, 1968
Plugging commenced April 12, 1968
Plugging completed April 12, 1968
Reason for abandonment of well or producing formation Dry Hole

NORTH

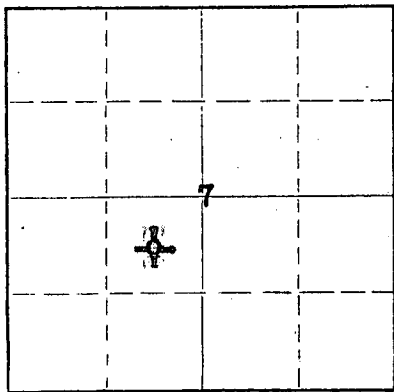

Locate well correctly on above
Section Plat

If a producing well is abandoned, date of last production _____ 19____
Was permission obtained from the Conservation Division or its agents before plugging was commenced? Yes

Name of Conservation Agent who supervised plugging of this well Leo Massey
Producing formation _____ Depth to top _____ Bottom _____ Total Depth of Well 4450 Feet
Show depth and thickness of all water, oil and gas formations.

OIL, GAS OR WATER RECORDS

CASING RECORD

FORMATION	CONTENT	FROM	TO	SIZE	PUT IN	PULLED OUT
		0'	312'	8-5/8"	312'	None

Describe in detail the manner in which the well was plugged, indicating where the mud fluid was placed and the method or methods used in introducing it into the hole. If cement or other plugs were used, state the character of same and depth placed, from _____ feet to _____ feet for each plug set.

RECEIVED
STATE CORPORATION COMMISSION
APR 22 1968
CONSERVATION DIVISION
Wichita, Kansas

4450' - 600' Mud
600' - 596' Plug
596' - 556' Cement, 70 sacks
556' - 300' Mud
300' - 296' Plug
296' - 256' Cement, 20 sacks
256' - 40' Mud
40' - 36' Plug
36' - 6' Cement, 10 sacks (Bottom of cellar)

(If additional description is necessary, use BACK of this sheet)

Name of Plugging Contractor Sun Cementing Co.
Address Great Bend, Kansas

STATE OF KANSAS COUNTY OF SEDGWICK, ss.

John H. Knightley (employee of owner) or (owner or operator) of the above-described well, being first duly sworn on oath, says: That I have knowledge of the facts, statements, and matters herein contained and the log of the above-described well as filed and that the same are true and correct. So help me God.

(Signature) John H. Knightley
301 S. Broadway, Wichita, Kansas
(Address)

SUBSCRIBED AND SWORN TO before me this 18th day of April, 19 68

My commission expires March 12, 1971

Stella J. Lips
Notary Public.

15735-20137-0000

D. R. Lauck Oil Company, Inc.

McCreight #1

C NE SW Sec. 7-20S-22W
Ness County, Kansas

Commenced: April 3, 1968
Completed: April 12, 1968

Casing Record: 312' 8-5/8" Cemented with 175 sacks Cement,
2% Calcium Chloride.

Elevation: GL 2256; DF 2258; KB 2260.

Drillers Log

Tops

		Samples	Electra
Surface Clay & Shale	75		
Shale, Shells	192	Blaine (driller) 832+1428	?
Sand	221	Anhydrite (driller) 1474+786	1470+790
Shale Shells	312	B. Anhydrite (") 1510+750	1506+754
Shale	525	Heebner 3721-1461	3720-1460
Sand	555	Lansing 3770-1510	3770-1510
Red Bed	832	Pawnee 4221-1961	4217-1957
Blaine	842	Ft. Scott 4288-2028	4288-2028
Red Bed	920	Cherokee 4315-2055	4314-2044
Sand	1128	Cherty Conglomerate 4380-2120	4382-2122
Shale & Red Bed	1305	Reworked Miss. 4386-2126	4386-2126
Red Bed	1474	Mississippian	
Anhydrite	1510	(Warsaw) 4398-2138	4396-2136
Shale & Shells	2130	Osage 4422-2162	4420-2160
Lime & Shale	2503	Rotary Total Depth 4450-2190	4449-2189
Lime	2665		
Lime & Shale	3545		
Lime	3675		
Lime & Shale	3775		
Lime	4190		
Lime & Shale	4385		
Lime, Shale, Chert	4400		
Chert	4450		

D&A

RECEIVED
STATE CORPORATION COMMISSION
APR 22 1968
CONSERVATION DIVISION
Wichita, Kansas