


Give All Information Completely
Make Required Affidavit
Mail or Deliver Report to:
Conservation Division
State Corporation Commission
211 No. Broadway
Wichita, Kansas

WELL PLUGGING RECORD

NORTH

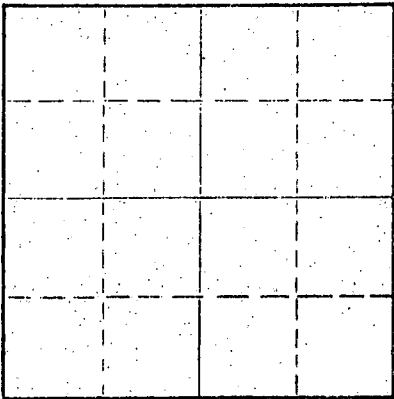

Locate well correctly on above
Section Plat

Ness County. Sec. 6 Twp. 20S Rge. 22 (E) (W) West
Location as "NE/CNW/SW" or footage from lines C SW SE
Lease Owner Mack Oil Company
Lease Name McCreight Well No. 1
Office Address 812 Union Center Building, Wichita, Kansas 67202
Character of Well (completed as Oil, Gas or Dry Hole) Dry Hole
Date well completed October 11 1964
Application for plugging filed October 12 1964
Application for plugging approved October 12 1964
Plugging commenced October 13 1964
Plugging completed October 13 - 1:00 p.m. 1964
Reason for abandonment of well or producing formation _____

If a producing well is abandoned, date of last production _____ 19____
Was permission obtained from the Conservation Division or its agents before plugging was commenced? Yes

Name of Conservation Agent who supervised plugging of this well Eldon Petty
Producing formation None Depth to top _____ Bottom _____ Total Depth of Well 4610 Feet
Show depth and thickness of all water, oil and gas formations.

OIL, GAS OR WATER RECORDS

CASING RECORD

FORMATION	CONTENT	FROM	TO	SIZE	PUT IN	PULLED OUT

Describe in detail the manner in which the well was plugged, indicating where the mud fluid was placed and the method or methods used in introducing it into the hole. If cement or other plugs were used, state the character of same and depth placed, from _____ feet to _____ feet for each plug set.

Plugged with 20 sacks common cement at 540'
20 sacks common cement at 240'
10 sacks common cement from 40' to top

RECEIVED
STATE CORPORATION COMMISSION
OCT 15 1964
CONSERVATION DIVISION
Wichita, Kansas

(If additional description is necessary, use BACK of this sheet)
Name of Plugging Contractor Mack Oil Company
Address P. O. Box 400, Duncan, Oklahoma 73533

STATE OF KANSAS COUNTY OF SEDGWICK, ss.
Robert L. Harris (employee of owner) or (~~owner or operator~~) of the above-described


well, being first duly sworn on oath, says: That I have knowledge of the facts, statements, and matters herein contained and the log of the above-described well as filed and that the same are true and correct. So help me God.

(Signature) Robert L. Harris

812 Union Center Building, Wichita, Kansas
(Address)

SUBSCRIBED AND SWORN TO before me this 14th day of October, 1964

September 21, 1968
Elizabeth L. Rice Notary Public.

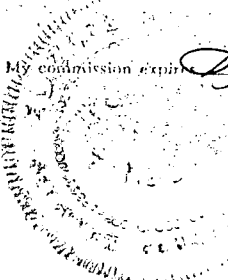

15.135.003322.0000

MACK OIL COMPANY
Duncan, Oklahoma

DRILLERS WELL LOG

McCreight #1

C SW SE Section 6-20S-22W
Ness County, Kansas
Elevation: 2258' Kelly Bushing
Initial Production: Dry
Contractor: Mack Oil Company

Commenced R. D.: 10- 1-64
Completed R. D.: 10-11-64
Total Depth: 4610'

STRATA	DEPTH
Top Soil & Shale	0 - 200'
Sand	200 - 230'
Shale & Shells	230 - 322'
Shale	322 - 800'
Sand & Shale	800 - 918'
Anhydrite Shale & Sand	918 - 1261'
Red Bed Shale & Shells	1261 - 1510'
Anhydrite	1510 - 1524'
Shale & Shells	1524 - 1575'
Shale	1575 - 2086'
Shale & Lime Streaks	2086 - 2270'
Lime	2270 - 2340'
Lime & Shale	2340 - 2505'
Lime	2505 - 2728'
Lime & Shale	2728 - 2865'
Lime	2865 - 3095'
Lime & Shale	3095 - 3755'
Lime	3755 - 3798'
Lime & Shale	3798 - 3920'
Lime	3920 - 4035'
Lime & Shale	4035 - 4098'
Lime	4098 - 4405'
Cherty Lime	4405 - 4422'
Lime	4422 - 4527'
Cherty Lime	4527 - 4580'
Chat & Lime	4580 - 4606'
Lime	4606 - 4610'

I hereby certify that the above is a true and correct log of said well as reflected by the daily drilling reports.

MACK OIL COMPANY

By Robert L. Harris
Robert L. Harris

Signed and sworn to in my presence this 14th day of October, 1964, by Robert L. Harris, representative of Mack Oil Company.

Elizabeth L. Rice
Notary Public

My commission expires: September 21, 1968

