


WELL PLUGGING RECORD

Give All Information Completely
Make Required Affidavit
Mail or Deliver Report to:
Conservation Division
State Corporation Commission
800 Birting Building
Wichita, Kansas

Harper County, Sec. 32 Twp. 32 Rge. 9 (E) W (W)

Location as "NE/CNW/SW" or footage from lines SW SW SW
Lease Owner Mull Drilling Co. Inc.
Lease Name Grigsby Well No. 1
Office Address 6405 E. Kellogg, Wichita, Kansas
Character of Well (completed as Oil, Gas or Dry Hole) Dry Hole
Date well completed Jan. 29 19 57
Application for plugging filed Jan. 30 19 57
Application for plugging approved Jan. 30 19 57
Plugging commenced ~~Midnight~~ 12:30 A.M. Jan. 30 19 57
Plugging completed Jan. 30 19 47
Reason for abandonment of well or producing formation Dry Hole

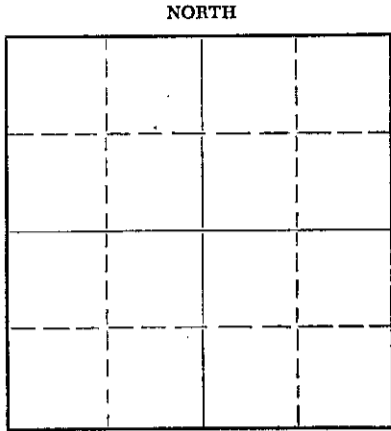

Locate well correctly on above Section Plat

If a producing well is abandoned, date of last production 19
Was permission obtained from the Conservation Division or its agents before plugging was commenced? Yes

Name of Conservation Agent who supervised plugging of this well Mr. Rives
Producing formation None Depth to top Bottom Total Depth of Well 4460 Feet
Show depth and thickness of all water, oil and gas formations.

OIL, GAS OR WATER RECORDS

CASING RECORD

FORMATION	CONTENT	FROM	TO	SIZE	PUT IN	PULLED OUT
				8 5/8	160'	None

Describe in detail the manner in which the well was plugged, indicating where the mud fluid was placed and the method or methods used in introducing it into the hole. If cement or other plugs were used, state the character of same and depth placed, from feet to feet for each plug set.

Hole was filled with heavy rotary mud, plug set at 200', 35 sacks of cement on top, put in through drill pipe by Service Company. Mud on top of cement, plug set at 25' 15 sacks of cement on top. Surface pipe cut off 4' Below ground level.

(If additional description is necessary, use BACK of this sheet)

Name of Plugging Contractor Company Tools
Address

STATE OF Kansas, COUNTY OF Harper, ss.
I, O. C. Arnott (employee of owner) or (owner or operator) of the above-described well, being first duly sworn on oath, says: That I have knowledge of the facts, statements, and matters herein contained and the log of the above-described well as filed and that the same are true and correct. So help me, God.

(Signature) *O. C. Arnott*
Attica, Kansas (Address)

SUBSCRIBED AND SWORN TO before me this 30 January 19 57

My commission expires Jan. 7, 1961

24-7868-5 3-53-20M

Notary Public.

PLUGGING
FILE SEC. 32 T. 32 R. 9 W.
BOOK PAGE 137 LINE 32

2-1-57

ROTARY DRILLERS LOG

COMPANY : Mull Drilling Co., Inc.
Wichita, Kansas

ROTARY DRILLING COMMENCED: 1-15-57

CONTRACTOR : Mull Drilling Co., Inc.
Wichita, Kansas

ROTARY DRILLING COMPLETED: 1-30-57

CASING RECORD : 8 5/8" @ 160' cemented
with 150 sacks cement

LOCATION: GRIGSBY #1
SW SW SW of Sec. 32-32S-9W
Harper County, Kansas

(Figures indicate bottom of formation - measurements from top of Rotary Bushing)

Red Bed	820
Shale & Shells	1375
Lime & Shale	1475
Lime	1980
Lime & Shale	3938
Lime	4316
Lime & Shale	4363
Lime (Mississippi)	4460' R.T.D. - D & A

I hereby certify that this is a true and correct copy of the above log to the best of my knowledge.

MULL DRILLING CO., INC.

BY *Joseph B. Brungardt, Jr.*
JOSEPH B. BRUNGARDT, JR.

STATE OF KANSAS)
COUNTY OF SEDGWICK) SS

Subscribed and sworn to before me this 1st day of February, 1957.



Ethel Zimmerman
NOTARY PUBLIC

MY COMMISSION EXPIRES: January 28, 1961.

PLUGGING
FILE SEC 32 T. 32 R. 9W
BOOK PAGE 137 LINE 32

RECEIVED
STATE CORPORATION COMMISSION
2-2-57
FEB - 2 1957
CONSERVATION DIVISION
Wichita, Kansas