

15-135-21400-0000


STATE OF KANSAS
STATE CORPORATION COMMISSION

WELL PLUGGING RECORD

Give All Information Completely
Make Required Affidavit
Mail or Deliver Report to
Conservation Division
State Corporation Comm.
245 North Water
Wichita, KS 67202

Ness County, Sec. 13 Twp. 19S Rge. 22 E/W
Location as "NE/CNW/SW" or footage from lines

SE SE
Lease Owner Brooks Hall Oil Corp.
Lease Name Schwein Well No. 1
Office Address 101 Park Ave. Bldg., Okla. City, Okla.
Character of Well (Completed as Oil, Gas or Dry Hole) dry hole

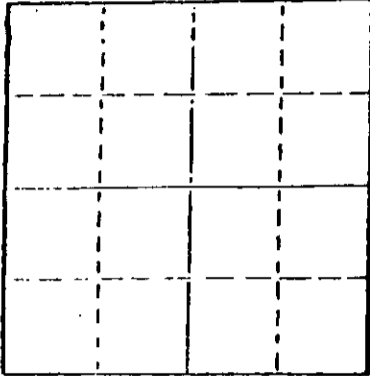

Locate well correctly on above
Section Plot

Date Well completed 12-22 1977
Application for plugging filed 12-22 1977
Application for plugging approved 12-22 1977
Plugging commenced 12-22 1977
Plugging completed 12-22 1977

Reason for abandonment of well or producing formation
no commercial quantities of oil or gas encountered
If a producing well is abandoned, date of last production 19

Was permission obtained from the Conservation Division or
its agents before plugging was commenced? yes

Name of Conservation Agent who supervised plugging of this well
Producing formation _____ Depth to top _____ Bottom _____ Total Depth of Well 4372
Show depth and thickness of all water, oil and gas formations.

OIL, GAS OR WATER RECORDS

CASING RECORD

FORMATION	CONTENT	FROM	TO	SIZE	PUT IN	PULLED OUT
Surface hole	shale	surf	282	8-5/8	274	none

Describe in detail the manner in which the well was plugged, indicating where the mud fluid was placed and the method or methods used in introducing it into the hold. If cement or other plugs were used, state the character of same and depth placed, from _____ feet to _____ feet for each plug set.

RECEIVED
STATE CORPORATION COMMISSION
DEC 30 1977
12-30-77
CONSERVATION DIVISION
Wichita, Kansas

Fluid to 600', plug. 70 sx
Fluid to 270', plug. 20 sx
Fluid to 40', plug 10 sx, 1/2 sx hulls

(If additional description is necessary, use BACK of this sheet)

Name of Plugging Contractor D N B DRILLING, INC.
515 R. H. Garvey Building
Wichita, Kansas 67202

STATE OF Kansas COUNTY OF Sedgwick, ss.
Ella Priess (employee of owner) or (owner or operator)
of the above-described well, being first duly sworn on oath, says: That I have knowledge of the facts, statements, and matters herein contained and the log of the above-described well as filed and that the same are true and correct. So help me God.

(Signature) Ella Priess
Suite 515 R.H. Garvey Bldg., Wichita, Ks.
(Address) 67202

SUBSCRIBED AND SWORN TO before me this 22nd day of December, 19 77

Dorothy L. Schmidt
Dorothy L. Schmidt Notary Public.

My commission expires 4/30/79

DOROTHY L. SCHMIDT
STATE NOTARY PUBLIC
Sedgwick County, Kansas
My Appt. Exp. April 30, 1979

15735-21400-0000

DRILLERS' LOG

BROOKS HALL OIL CORP.
No. 1 Schwein
SE SE Sec. 13-19S-22W
Ness Co., Kansas

Commenced: 12-15-77
Completed: 12-23-77

Surface Casing: 273.90' of 8-5/8"
cemented w/155 sx common, 2% gel, 3% cc
12-15-77

FORMATION

DEPTH

Surface Hole	0 - 282
Sand & Shale	282 - 492
Shale	492 - 870
Sand	870 - 1085
Shells & Shale	1085 - 1375
Red Bed & Shale	1375 - 1430
Anhydrite	1430 - 1464
Shale	1464 - 1930
Shale & Lime	1930 - 2280
Lime & Shale	2280 - 3820
Lime	3820 - 4372 RTD

I do hereby certify that the foregoing statements are true and correct to the best of my knowledge and belief.

D N B DRILLING, INC.

Ella Priess

Ella Priess

RECEIVED
STATE CORPORATION COMMISSION

DEC 30 1977

STATE OF KANSAS: ss:

CONSERVATION DIVISION
Wichita, Kansas

Subscribed and sworn to before me this 27th day of December, 1977.

Dorothy L. Schmidt

Dorothy L. Schmidt, Notary Public

DOROTHY L. SCHMIDT
STATE NOTARY PUBLIC
Sedgwick County, Kansas
My Appt. Exp. April 30, 1979