


STATE OF KANSAS
STATE CORPORATION COMMISSION

WELL PLUGGING RECORD

Give All Information Completely
Make Required Affidavit
Mail or Deliver Report to
Conservation Division
State Corporation Comm.
245 North Water
Wichita, KS 67202

Ness County, Sec. 13 Twp. 19 Rge. 22 E/W
Location as "NE/CNW $\frac{1}{4}$ SW $\frac{1}{4}$ " or footage from lines
C SE NE

Lease Owner Meltzer Oil Company
Lease Name Schwien B Well No. 1
Office Address Drawer B, Great Bend, Kansas 67530
Character of Well (Completed as Oil, Gas or Dry Hole)

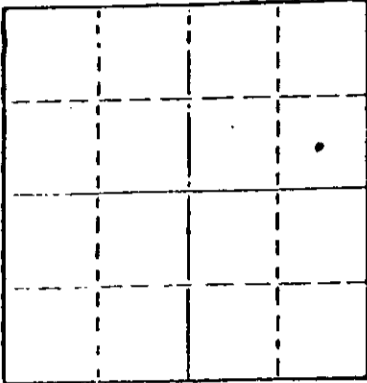

Locate well correctly on above
Section Plot

oil
Date Well completed 19
Application for plugging filed 19
Application for plugging approved Feb. 14 19 77
Plugging commenced Feb. 23 19 77
Plugging completed Mar. 1 19 77

Reason for abandonment of well or producing formation
depleted
If a producing well is abandoned, date of last production 19

Was permission obtained from the Conservation Division or
its agents before plugging was commenced? yes

Name of Conservation Agent who supervised plugging of this well Leo Massey
Producing formation Depth to top Bottom Total Depth of Well 4360'
Show depth and thickness of all water, oil and gas formations.

OIL, GAS OR WATER RECORDS

CASING RECORD

FORMATION	CONTENT	FROM	TO	SIZE	PUT IN	PULLED OUT
			410'	8 5/8"	410'	none
			4360'	4 1/2"	4360'	3322.98

Describe in detail the manner in which the well was plugged, indicating where the mud fluid
was placed and the method or methods used in introducing it into the hold. If cement or other
plugs were used, state the character of same and depth placed, from _____ feet to
_____ feet for each plug set.

Sanded back to 4275' and dumped 3 sacks of cement.

Allied Cementing Company plugged well pumping in 1 sack of hulls, 25 sacks
of gel and 100 sacks of cement.

RECEIVED
STATE CORPORATION COMMISSION

MAR 03 1977

CONSERVATION DIVISION
Wichita, Kansas

If additional description is necessary, use BACK of this sheet)
Name of Plugging Contractor PIPE PULLERS, INC.
Box 128, Ellinwood, Kansas 67526

STATE OF KANSAS COUNTY OF BARTON, ss.
Evelyn Roth (employee of owner) or (owner or operator)
of the above-described well, being first duly sworn on oath, says: That I have knowledge of
the facts, statements, and matters herein contained and the log of the above-described well
as filed and that the same are true and correct. So help me God.

(Signature) Evelyn Roth
Ellinwood, Kansas
(Address)

SUBSCRIBED AND SWORN TO before me this 2nd day of March, 1977

My commission expires

JENNY KASSELMAN
NOTARY PUBLIC
BARTON COUNTY, KANSAS
MY COMM. EXP. JULY 16, 1978

Jenny Kaselman
Notary Public.

MELTZER OIL COMPANY & DONALD C. STAMSON
 #1 Schwien 'B'
 C SE NE Sec. 13-19-22W
 Ness County, Kansas
 Lease K-5021, #76-5 Meltzer

Contractor: Slawson
 Elevation: 2178 KB
 Geologist: George Mueller
 PTD: 4450'

15-135-21266-0000

November 9, 1976	Spud - Set 8 5/8" @ 418' w/300 sx: PD 7:10 A.M.	
November 10, 1976	WOC @ 425'	ANH 1411 (+767)
November 11, 1976	Drlg @ 1655'	B/ANH 1444 (+734)
November 12, 1976	Drlg @ 2520'	HEEB 3643 (-1465)
November 13, 1976	Drlg @ 3175'	TORO 3661 (-1483)
November 14, 1976	Drlg @ 3835'	LANS 3692 (-1514)
November 15, 1976	Drlg @ 4075'	MARM 4027 (-1849)
November 16, 1976	Trip @ 4214' - Mud is aired up, conditioning mud.	PAWN 4102 (1924)
November 17, 1976	DST #1 4230-4277 (MISS), WBTO, Rec. 50' SOCM, IFP 44-44#, ISIP 1059#, FFP 53-53#, FSIP 976#	U/CK 4173 (-1995)
November 18, 1976	DST #2 4278-4287, 30-45-45-60, MISS, FB/45", WB/45", Rec. 63' HOCM, (7% G, 33% O, 60% M), 20' CO 41° @ 60, 63' M w/tr oil, IFP 71-71#, ISIP 1167#, FFP 80-80#, FSIP 1122#	FT SCT 4177 (-1999)
November 19, 1976	DST #3 4287-4294 (MISS), WBTO, 30-45-45-60, Rec. 5' CO, 30' M, IFP 17-17#, ISIP 1122#, FFP 26-26# FSIP 1050#	CK SD 4199 (-2021)
November 20, 1976	DST #4 4294-4301 (MISS), SBTO, 30-45-45-60, Rec. 63' GIP, 393' TF, 94' MO (11-13% W), 267' CGO 40°, 32' SW, IFP 17-71#, ISIP 1283#, FFP 89-151#, FSIP 1283#	MISS 4272 (-2094)
	RTD 4360' - Ran EL - Ran 4 1/2" csg set @ 4359' w/175 sx: PD 10:00 A.M. - WOCT.	RTD 4360 (-2182)

LOG TOPS
 ANH 1412 (+766)
 HEEB 3643 (-1465)
 LANS 3690 (-1512)
 B/KC 3990 (-1812)
 PAWN 4102 (-1924)
 CK 4172 (-1994)
 FT SCT 4178 (-2000)
 SD 4200 (-2022)
 MISS 4271 (-2093)
 LTD 4360 (-2182)

FEB 14 1977