


15195-21046-0000

STATE OF KANSAS
STATE CORPORATION COMMISSION
CONSERVATION DIVISION
P. O. BOX 17027
WICHITA, KANSAS 67217

FORM CP-4

WELL PLUGGING RECORD

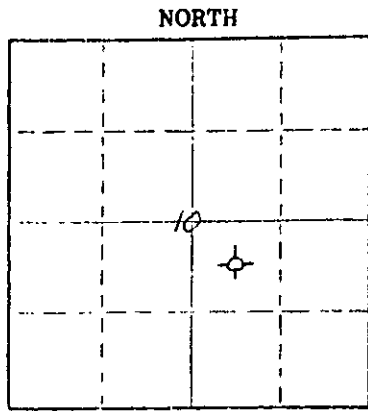

Locate well correctly on above Section Plat

Ness County. Sec. 10 Twp. 19S Rge. 22 (E) (W)
Location as "NE/CNW&SW" or footage from lines. C NW SE
Lease Owner Mack Oil Co.
Lease Name Schaben Well No. 1
Office Address 812 Union Center Bldg., Wichita, KS 67202
Character of Well (completed as Oil, Gas or Dry Hole) Dry hole
Date well completed 5-12-75 19
Application for plugging filed 5-12-75 19
Application for plugging approved 5-12-75 19
Plugging commenced 5-12-75 19
Plugging completed 5-12-75 19
Reason for abandonment of well or producing formation commercial quantities of oil not found.
If a producing well is abandoned, date of last production 19
Was permission obtained from the Conservation Division or its agents before plugging was commenced? yes

Name of Conservation Agent who supervised plugging of this well Leo Massey-Hays, KS
Producing formation _____ Depth to top _____ Bottom _____ Total Depth of Well 4350 Feet
Show depth and thickness of all water, oil and gas formations.

OIL, GAS OR WATER RECORDS

CASING RECORD

FORMATION	CONTENT	FROM	TO	SIZE	PUT IN	PULLED OUT
				8-5/8"	363'	

Describe in detail the manner in which the well was plugged, indicating where the mud fluid was placed and the method or methods used in introducing it into the hole. If cement or other plugs were used, state the character of same and depth placed, from _____ feet to _____ feet for each plug set.

Plug @ 550' w/50 sx
240' w/25 sx
40' & solid bridge w/10 sx

RECEIVED
STATE CORPORATION COMMISSION
MAY 19 1975
CONSERVATION DIVISION
Wichita, Kansas

(If additional description is necessary, use BACK of this sheet)
Name of Plugging Contractor Rains & Williamson Oil Co., Inc.
Address 435 Page Court, 220 W. Douglas, Wichita, KS 67202

STATE OF Kansas COUNTY OF Sedgwick ss.
Wilson Rains, President (employee of owner) or (owner or operator) of the above-described well, being first duly sworn on oath, says: That I have knowledge of the facts, statements, and matters herein contained and the log of the above-described well as filed and that the same are true and correct. So HELP ME GOD.

(Signature) Wilson Rains Wilson Rains
435 Page Court, 220 W. Douglas, Wichita, KS 67202 (Address)

Subscribed AND SWORN to before me this 14th day of May, 1975
My commission expires October 4, 1975
Juanita M. Green Notary Public.



WELL LOG

15-135-21046-0000

COMPANY Mack Oil Co.

SEC. 10 T. 19S R. 22W
LOC. C NW SE

FARM Schaben

NO. 1


RIG. NO. 1

TOTAL DEPTH 4350'

COMM. 4-30-75

COMP. 5-12-75

COUNTY Ness
KANSAS

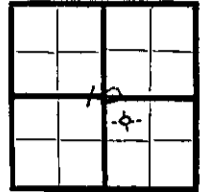

CONTRACTOR Rains & Williamson Oil Co., Inc.

CASING

20	10	
15	8-5/8" @ 363'	w/250 sx common, 2% gel ELEVATION
12	6	3% cc
13	5	

PRODUCTION D&A

FIGURES INDICATE BOTTOM OF FORMATIONS

Surface	383
Shale	955
Dakota Sands	1140
Shale	1496
Anhydrite	1520
Shale	2468
Lime & Shale	3115
Lime	3392
Lime & Shale	3683
Lime	4350
<u>Rotary Total Depth</u>	<u>4350</u>

RECEIVED
STATE CORPORATION COMMISSION
MAY 19 1975
CONSERVATION DIVISION
Wichita, Kansas

State of Kansas
County of Sedgwick ss:

I, Wilson Rains, President of the Rains & Williamson Oil Company, Inc.

upon oath state that the above and foregoing is a true and correct copy of the log of the Schaben #1 well.

Wilson Rains
Wilson Rains

Subscribed and sworn to before me this 14th day of May 1975

My Commission Expires: October 4, 1975

Juanita M. Green
NOTARY PUBLIC
Juanita M. Green

