

15-007-20503-0000


STATE OF KANSAS
STATE CORPORATION COMMISSION

WELL PLUGGING RECORD

Give All Information Completely
Make Required Affidavit
Mail or Deliver Report to
Conservation Division
State Corporation Comm.
245 North Water
Wichita, KS 67202

Barber County, Sec. 9 Twp. 31S Rge. 14W #1/W
Location as "NE/CNW/SW" or footage from lines
C E/2 NE/4 NW/4

Lease Owner National Crude, Inc.
Lease Name Mills Well No. 2
Office Address 7701 E. Kellogg, Suite 540, Wichita, Ks. 67202
Character of Well (Completed as Oil, Gas or Dry Hole)
D & A

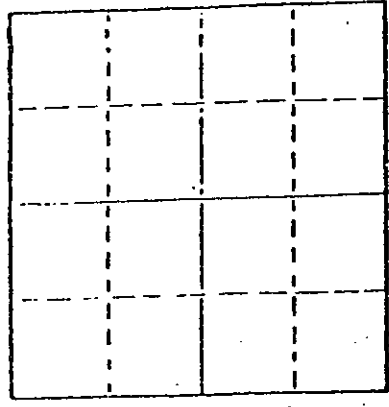

Locate well correctly on above Section Plot

Date Well completed June 6, 1977
Application for plugging filed June 6, 1977
Application for plugging approved June 6, 1977
Plugging commenced June 6, 1977
Plugging completed June 6, 1977
Reason for abandonment of well or producing formation
D & A

If a producing well is abandoned, date of last production
19

Was permission obtained from the Conservation Division or
its agents before plugging was commenced? Yes

Name of Conservation Agent who supervised plugging of this well J. H. Metz
Producing formation Depth to top Bottom Total Depth of Well 13,010
Show depth and thickness of all water, oil and gas formations.

OIL, GAS OR WATER RECORDS

CASING RECORD

FORMATION	CONTENT	FROM	TO	SIZE	PUT IN	PULLED OUT
				8 5/8"	222.05'	-0-

Describe in detail the manner in which the well was plugged, indicating where the mud flux
was placed and the method or methods used in introducing it into the hold. If cement or other
plugs were used, state the character of same and depth placed, from feet to
feet for each plug set.

Plug @ 240' w/35 sx cement
Bridge @ 40' w/2 sx hulls & 12 sx cement
5 sx cement in rathole

RECEIVED
STATE CORPORATION COMMISSION

JUL 21 1977
7-21-77
CONSERVATION DIVISION
WICHITA, KANSAS

(If additional description is necessary, use BACK of this sheet)

Name of Plugging Contractor Red Tiger Drilling Company
1720 KSB&T Building, Wichita, Kansas 67202


STATE OF Kansas COUNTY OF Sedgwick, ss. contractor
Gloria Fawcett (employee of ~~xxxxxx~~)
of the above-described well, being first duly sworn on oath, says: That I have knowledge of
the facts, statements, and matters herein contained and the log of the above-described well
as filed and that the same are true and correct. So help me God.

(Signature) Gloria Fawcett
1720 KSB&T Building, Wichita, Kansas 67202
(Address)

SUBSCRIBED AND SWORN TO before me this 10th day of June, 1977.

D'Ann Drennan
Notary Public.

My commission expires

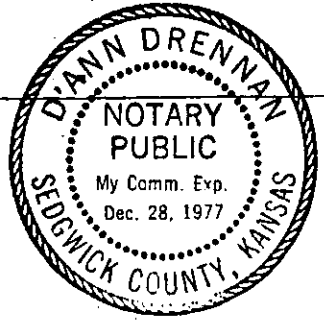

15-007-20503-0000

DRILLERS LOG

No. 2 Mills

CASING RECORD:	COMPANY:	National Crude, Inc.	DESCRIPTION:
8 5/8" @ 229' w/200 sx cement	CONTRACTOR:	Red Tiger Drilling Company	C E/2 NE/4 NW/4 Sec. 9-T31S-R14W Barber County, Kansas
	COMMENCED:	June 1, 1977	
	COMPLETED:	June 6, 1977	
TOTAL DEPTH: 3,010'			ELEVATION: 1,656' KB

<u>FORMATION</u>	<u>FROM</u>	<u>TO</u>	<u>REMARKS</u>
Surface Soil & Shale	0	440	
Shale	440	1635	
Shale w/Lime Streaks	1635	1868	
Lime	1868	2650	
Lime & Sand	2650	2750	
Sandy Lime	2750	2755	
Lime	2755	2935	
Cherty Lime	2935	2938	
Lime	2938	3010	
RTD		3010	


I certify that this is a true and correct copy of the above log to the best of my knowledge.

RED TIGER DRILLING COMPANY

Gloria Fawcett
Gloria Fawcett

Subscribed and sworn to before me this 10th day of June, 1977.

D'Ann Drennan
Notary Public

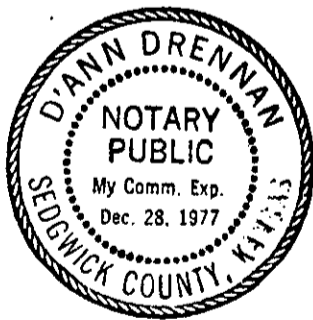

RECEIVED
STATE CORPORATION COMMISSION
JUL 21 1977
7-21-77
CONSERVATION DIVISION
Wichita, Kansas