


15-007-10171-0000

STATE OF KANSAS  
STATE CORPORATION COMMISSION

WELL PLUGGING RECORD

Give All Information Completely  
Make Required Affidavit  
Mail or Deliver Report to:  
Conservation Division  
State Corporation Commission  
800 Bitting Building  
Wichita, Kansas

Barber County, Sec. 9 Twp. 31S Rge. 14 (X) (W)  
Location as "NE/CNW&SW" or footage from lines Sen SW NE SW  
Lease Owner J.M. Huber Corp. & Bishop Oil Co.  
Lease Name Skinner "A" Well No. 3  
Office Address Box 978 Liberal, Kansas  
Character of Well (completed as Oil, Gas or Dry Hole) Oil  
Date well completed 2-9-47 19\_\_\_\_  
Application for plugging filed 4-10-53 19\_\_\_\_  
Application for plugging approved 4-13-53 19\_\_\_\_  
Plugging commenced 4-28-53 19\_\_\_\_  
Plugging completed 5-2-53 19\_\_\_\_  
Reason for abandonment of well or producing formation Formation Dry  
If a producing well is abandoned, date of last production \_\_\_\_\_ 19\_\_\_\_  
Was permission obtained from the Conservation Division or its agents before plugging was commenced? Yes

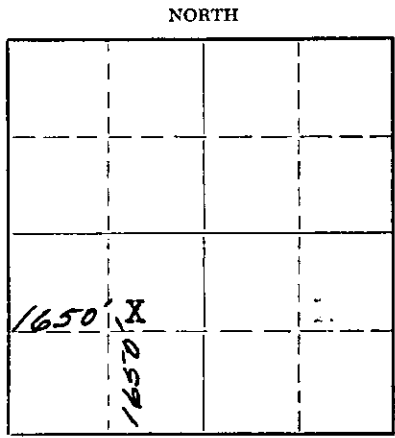

Locate well correctly on above Section Plat

Name of Conservation Agent who supervised plugging of this well Mr. M.A. Rives  
Producing formation Viola Depth to top 4355' Bottom 4359' Total Depth of Well 4365 Feet  
Show depth and thickness of all water, oil and gas formations.

OIL, GAS OR WATER RECORDS

CASING RECORD

FORMATION	CONTENT	FROM	TO	SIZE	PUT IN	PULLED OUT
Viola	Oil	4355'	4359'	24"	23'	None
				16"	131'	None
				10"	818'	None
				6 5/8"	4344'	3280'

Describe in detail the manner in which the well was plugged, indicating where the mud fluid was placed and the method or methods used in introducing it into the hole. If cement or other plugs were used, state the character of same and depth placed, from \_\_\_\_\_ feet to \_\_\_\_\_ feet for each plug set.

Filled hole with rock from 4365' to 4330'. Dumped 5 sacks of cement at 4330'. Shot and recovered 3280' of 6 5/8" casing. Filled Hole to surface with 40 sacks of mud and 150 sacks of cement.

(If additional description is necessary, use BACK of this sheet)

Name of Plugging Contractor Carroll Bros Casing Pulling Co.  
Address Ellinwood, Kansas

STATE OF Kansas, COUNTY OF Pratt, ss. R.E. McDaniel (employee of owner) or (~~owner/operator~~) of the above-described well, being first duly sworn on oath, says: That I have knowledge of the facts, statements, and matters herein contained and the log of the above-described well as filed and that the same are true and correct. So help me God.

(Signature) R.E. McDaniel

Box 978 Liberal, Kansas  
(Address)

SUBSCRIBED AND SWORN TO before me this 26th day of May, 1953

My commission expires September 10, 1955

24-2675-S 2-52-20M

[Signature] Notary Public.

**PLUGGING**  
FILE SEC 9 T 31 R 14 W  
BOOK PAGE 92 LINE 3

RECEIVED  
STATE CORPORATION COMMISSION  
MAY 28 1953  
5-28-53  
CONSERVATION DIVISION  
Wichita, Kansas

DRILLER'S LOG

COMPANY: **DISCOIL OIL COMPANY & J.M. HUBER CORPORATION**  
 CONTRACTOR: **J.M. HUBER CORPORATION**

LOCATION: **BOX 107, 9-318-147, Border County, Kansas.**

WELL NAME: **Scriner #A# 03**  
 COMPLETION: **11-24-47**  
 CO. FILED: **2-9-47**

PRODUCTION: **236 BOPD & 103 wtr. 1,000 MCF**

CASING USED:	2 1/2"	3"	4"	5"	6"
	10'	131'	110'	460'	
	10'				
	0'		1310'		

Sand gravel & clay	60
Red bed & shales	130
Red bed	145
Gyp shales & red beds	045
Shale & shales	1230
Salt beds & shale & shales	1440
Salt, shale & shales	1460
Shale shales, lime streaks	1675
Shale shales	1720
Lime	1780
Broken lime	1885
Lime & shale	1975
Lime - broken	2965
Broken lime & shale	2160
Lime - shale	2360
Lime & shale streaks	2450
Lime & shale	2650
Shale & lime	2805
Lime with shale streaks	3060
Lime - shale	3140
Broken lime & shale	3240
Lime & shale	3435
Broken lime	3520
Lime & shale	3945
Lime - shale breaks	3995
Lime	4213
Lime - shale streaks	4251
Lime & shale	4266
Lime	4317
Maguelata Dolomite	4322
Charly Dolomite	4350
	4365
<b>Total Depth</b>	<b>4365</b>

BARRETT CORP:

Lower Douglas Sand	3735-48
Top Lansing	3752
Maguelata	4316-50 RSD
<b>Total Depth</b>	<b>4365</b>

500 acid @ 2.0. 1,000 acid, 7000 to 2000 in 3 minutes on vacuum, mudded down & flowed estimated 60 to 80 bbls fourth hour. Shut in. Opened & flowed 104 bbls/hr.; estimated 1,000 MCF.

No. 763 HO & 3/16 BU/S hrs.

W. Potential = 236 BOPD & 103 wtr.

STATE OF KANSAS )  
 COUNTY OF SIMPSON ) SS

I hereby certify that the above is a true and correct copy of the log of the Well No. 3 "A" located in the Center of the Southeast Quarter of the Northeast Quarter of the Southwest Quarter of Section 9, Township 31 South, Range 14 West, Border County, Kansas.

*Edward A. Huffman*  
 Edward A. Huffman, District Manager  
 J.M. Huber Corporation

Subscribed and sworn to before me this 24th day of February, 1948.

*Annetta Spruell*  
 Notary Public

My Commission expires June 7, 1950.

**PLUGGING**  
 REC-9-T31-R14W  
 COOK PAGE 22 LINE 3

**RECEIVED**  
 CORPORATION COMMISSION

MAY 23 1953  
 5-2853  
 RECORDS DIVISION  
 Kansas