


STATE OF KANSAS  
STATE CORPORATION COMMISSION

Form CP-4

WELL PLUGGING RECORD

Give All Information Completely  
Make Required Affidavit  
Mail or Deliver Report to:  
Conservation Division  
State Corporation Commission  
P. O. Box 17027  
Wichita, Kansas 67217  
NORTH

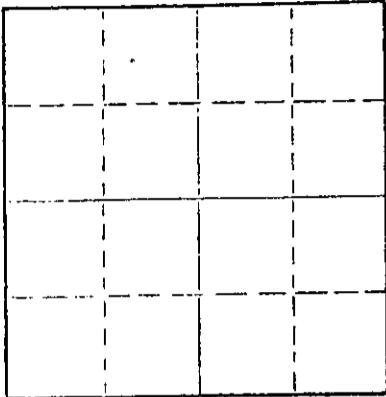

Locate well correctly on above  
Section Plat

Barber County, Sec 5 Twp 31S Rge 14W (E) (W)  
Location as "NE/CNW/SW" or footage from lines C SW SE  
Lease Owner National Oil Company  
Lease Name Mills Well No. 1  
Office Address Suite 550, 200 W. Douglas, Wichita, Kansas  
Character of Well (completed as Oil, Gas or Dry Hole) D & A  
Date well completed March 27 19 74  
Application for plugging filed March 27 19 74  
Application for plugging approved March 27 19 74  
Plugging commenced March 27 19 74  
Plugging completed March 27 19 74  
Reason for abandonment of well or producing formation D & A

If a producing well is abandoned, date of last production 19  
Was permission obtained from the Conservation Division or its agents before plugging was commenced? Yes

Name of Conservation Agent who supervised plugging of this well G. R. Bieberstein  
Producing formation Depth to top Bottom Total Depth of Well 4540 Feet  
Show depth and thickness of all water, oil and gas formations.

OIL, GAS OR WATER RECORDS

CASING RECORD

FORMATION	CONTENT	FROM	TO	SIZE	PUT IN	PULLED OUT
			9 3/4"	3 jrts		
			8 5/8	24 jts	781'	-0-

Describe in detail the manner in which the well was plugged, indicating where the mud fluid was placed and the method or methods used in introducing it into the hole. If cement or other plugs were used, state the character of same and depth placed, from feet to feet for each plug set.

Plug @ 750' w/25 sx,  
315' w/25 sx, 40' w/10 sx.  
rathole plugged.

RECEIVED  
STATE CORPORATION COMMISSION  
APR 30 1974  
CONSERVATION DIVISION  
Wichita, Kansas

(If additional description is necessary, use BACK of this sheet)  
Name of Plugging Contractor B & B Drilling, Inc.  
Address 720 Union Center, Wichita, Ks.

STATE OF Kansas COUNTY OF Sedgwick ss.  
Bill Lahar (employee of owner) or (owner or operator) of the above-described well, being first duly sworn on oath, says: That I have knowledge of the facts, statements, and matters herein contained and the log of the above-described well as filed and that the same are true and correct. So help me God.

(Signature) Bill Lahar  
Bill Lahar  
720 Union Center, Wichita, Kansas  
(Address)

SUBSCRIBED AND SWORN to before me this 29 day of March, 19 74

My commission expires 1-29-77

Betty M. Maloney  
Betty M. Maloney Notary Public.

15-007-20263-0000

March 29, 1974

DRILLERS LOG

RECEIVED  
STATE CORPORATION COMMISSION

APR 3 - 1974  
4-3-74  
CONSERVATION DIVISION  
Wichita, Kansas

#1 Mills  
C SW SE  
Sec. 5-31S-14W  
Barber County, Kansas

OPERATOR: National Oil Company  
CONTRACTOR: B & B Drilling, Inc.  
COMMENCED: March 17, 1974  
COMPLETED: March 27, 1974

3 jts 9 3/4", 24 jts 8 5/8" @ 781' w/500 sx

0	794	Surface soil	
794	1350	Shale	
1350	1771	Shale & Sand	
1771	2920	Shale & Lime	
2920	3030	Lime	
3030	3790	Lime & Shale	
3790	4540	Lime	
4540		RTD	D & A

We certify that the above and foregoing is a true and correct copy of the log on the #1 Mills, located in Barber County, Kansas.

B & B DRILLING, INC.

Bill Lahar  
Bill Lahar

Subscribed and sworn to before me this 29th day of March, 1974.

Betty M. Maloney  
Betty M. Maloney Notary Public

My Commission Expires:

January 29, 1977