

STATE OF KANSAS
STATE CORPORATION COMMISSION


WELL PLUGGING RECORD

OR
FORMATION PLUGGING RECORD

Strike out upper line
when reporting plug-
ging off formations.

Give All Information Completely
Make Required Affidavit
Mail or Deliver Report to:
Conservation Division
State Corporation Commission
800 Bittling Building
Wichita, Kansas

NORTH

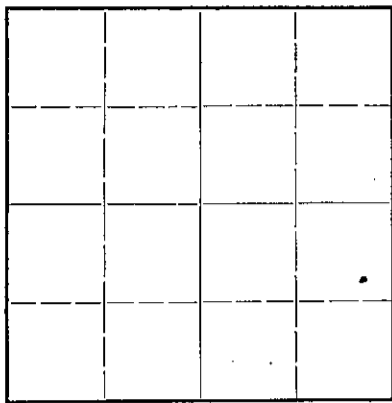

Locate well correctly on above
Section Plat

Barber County. Sec. 5 Twp. 31S Rgc. (E) 14 (W)
Location as "NE $\frac{1}{4}$ NW $\frac{1}{4}$ SW $\frac{1}{4}$ " or footage from lines Center SE $\frac{1}{4}$ of NE $\frac{1}{4}$ of SE $\frac{1}{4}$
Lease Owner. Amerada Petroleum Corporation
Lease Name. T. H. Mills Well No. 1
Office Address. Box 2040, Tulsa, Oklahoma
Character of Well (completed as Oil, Gas or Dry Hole) Dry Hole
Date well completed. January 8, 19 47
Application for plugging filed. 19
Application for plugging approved. 19
Plugging commenced. January 9, 19 47
Plugging completed. January 9, 19 47
Reason for abandonment of well or producing formation. Dry Hole

If a producing well is abandoned, date of last production. 19
Was permission obtained from the Conservation Division or its agents before plugging was com-
menced? Yes

Name of Conservation Agent who supervised plugging of this well. H. W. Kerr, 1110 Morphy, Great Bend, Kansas
Producing formation. Depth to top. Bottom. Total Depth of Well. 4531 Feet
Show depth and thickness of all water, oil and gas formations.

OIL, GAS OR WATER RECORDS

CASING RECORD

Formation	Content	From	To	Size	Put In	Pulled Out
Douglass Sand	Dry	3681'		8-5/8"	817'	None
Lancing Lime	"	3798'				
Viola Lime	"	4398'				
Simpson	"	4520'				


Describe in detail the manner in which the well was plugged, indicating where the mud fluid was placed and the method or methods used in introducing it into the hold. If cement or other plugs were used, state the character of same and depth placed, from feet to feet for each plug set.

Ran Drill Pipe in hole to 2200', Circulated heavy mud, set Halliburton Plug @ 300'.
Halliburton mixed & pumped in through Drill Pipe 20 sacks of Reg. Cement, filled hole
with heavy mud, to within 54' of top of hole, Set Halliburton Plug, Halliburton mixed
& Pumped in 15 sacks of Reg. Cement.

PLUGGING
FILE SEC 5 31S 14W
BOOK PAGE 93 LINE 8

(If additional description is necessary, use BACK of this sheet)

Correspondence regarding this well should be addressed to Amerada Petroleum Corporation
Address. Box 2040, Tulsa, Oklahoma

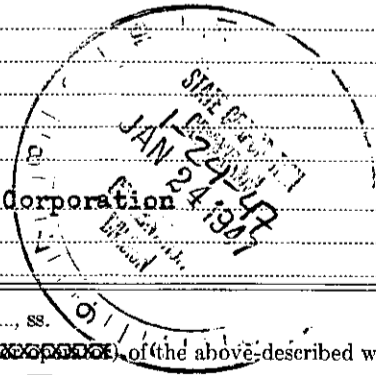

STATE OF Oklahoma, COUNTY OF Tulsa, ss.
C. N. Rose (employee of owner) of the above-described well,
being first duly sworn on oath, says: That I have knowledge of the facts, statements, and matters herein contained and the log of the above-
described well as filed and that the same are true and correct. So help me God.

(Signature) [Handwritten Signature]

P. O. Box 387, Burrton, Kansas
(Address)

SUBSCRIBED AND SWORN to before me this 21st day of January, 1947.

My commission expires September 8, 1949

J. C. Arrington
Notary Public.

Well No. 1
 Farm Temple H. Mills
 Elevation 1686'
 Location 990' from North line
 330' from East line
 SE/4 NE/4 SE/4
 Section 5-31S-14W
 Barber County, Kansas
 Company Amerada Petroleum Corporation
 Commenced Drlg. 12-9-46
 Completed Drlg. 1-7-47
 Contractor Glenn W. Peel
 Initial Prod. Dry Hole

Casing Record:	SIZE	WEIGHT	FEET	CEMENT	PERFORATIONS
	8-5/8"	32#	817	450 Sx.	None

FORMATION

Clay	0	32
Sand	32	35
Shale	35	70
Sand	70	1272
Shale	72	113
Sand	113	132
Shale	132	335
Shale & shells	335	480
Shale & sand streaks	480	525
Shale & Anhydrite	525	637
Shale & shells	637	1302
Broken salt & shale	1302	1565
Anhydrite & shale	1565	1580
Shale & lime streaks	1580	1733
Lime & shale	1733	1790
Anhydrite	1790	1960
Anhydrite & shale	1960	2009
Broken anhydrite & shale	2009	2067
Lime & shale streaks	2067	2137
Lime & shale	2137	2198
Broken lime & chert	2198	2246
Lime	2246	2281
Lime & shale streaks	2281	2331
Broken lime & shale	2331	2382
Lime	2382	2415
Lime & shale streaks	2415	2435
Broken lime	2435	2500
Lime & shale streaks	2500	2570
Lime & shale	2570	2617
Broken lime & shale	2617	2689
Shale & lime streaks	2689	2804
Shale & lime	2804	2972
Lime & shale streaks	2972	3090
Lime	3090	3665
Shale & sand	3665	3743
Lime	3743	3817
Shale	3817	3852
Lime & shale streaks	3852	3907
Lime	3907	3928
Lime & shale	3928	3958
Lime	3958	4364
Conglomerate	4364	4380
Lime & chert	4380	4403
Lime	4403	4430
Cherty lime	4430	4458
Chert	4458	4467
Cherty lime	4467	4482
Lime	4482	4496
Cherty lime	4496	4512
Lime	4512	4529
Sand	4529	4531 TD

Plugged & abandoned 1-10-47

