

NOTICE OF INTENTION TO DRILL

(see rules on reverse side)

✓ → A

Expected Spud Date. 11/25/88 month day year

API Number 15- 007-22,212-00-00 150' SE of C NE 1/4 NE 1/4 Sec. 2 Twp. 33 S, Rg. 12 East West 4515 555 Ft. from South Line of Section Ft. from East Line of Section

OPERATOR: License # 5020 Name Rine Exploration Company Address Suite #645, 300 W. Douglas City/State/Zip Wichita, KS 67202-2904 Contact Person M. Bradford Rine Phone 316/262-5418

(Note: Locate well on Section Plat on reverse side) Nearest lease or unit boundary line 555 feet County Barber Lease Name Bartholow Well # 1-2

CONTRACTOR: License # 5929 Name Duke Drilling Company, Inc. City/State Wichita, KS 67202

Ground surface elevation 1456 (L&S) feet MSL Domestic well within 330 feet: yes X no Municipal well within one mile: yes X no

Well Drilled For: Well Class: Type Equipment: X Oil Storage Infield X Mud Rotary X Gas Inj Pool Ext. Air Rotary OWWO Expl Wildcat Cable

Depth to bottom of fresh water. 58' / 150' Depth to bottom of usable water 200' Surface pipe by Alternate: 1 X 2

If OWWO: old well info as follows: Operator Well Name Comp Date Old Total Depth

Surface pipe planned to be set 240' Conductor pipe required -0- Projected Total Depth 4900 feet Formation Simpson

I certify that well will comply with K.S.A. 55-101, et seq., plus eventually plugging hole to KCC specifications. Date 11/15/88 Signature of Operator or Agent M. Bradford Rine Title President & Geologist

For KCC Use: Conductor Pipe Required feet; Minimum Surface Pipe Required 220' feet per Alt. (1) This Authorization Expires 5-18-89 Approved By LKM 11-18-88


EFFECTIVE DATE: 11-23-88

Must be filed with the K.C.C. five (5) days prior to commencing well  
This card void if drilling not started within six (6) months of date received by K.C.C.

### Important procedures to follow:

1. Notify District office before setting surface casing.
2. Set surface casing by circulating cement to the top.
3. File completion forms ACO-1 with K.C.C. within 120 days of well spud date, following instructions on ACO-1, side 1, and including copies of wireline logs.
4. Notify District office 48 hours prior to old well workover or re-entry.
5. Prior to filing Intent, prepare a proposed plugging plan in case well is D & A, then obtain approval of plan when calling district office prior to setting surface pipe.
6. Submit plugging report (CP-4) to K.C.C. after plugging is completed.
7. Obtain an approved injection docket number before disposing of salt water.
8. Notify K.C.C. within 10 days when injection commences or terminates.
9. If an alternate 2 completion, cement in the production pipe from below any usable water to surface within 120 days of spud date.

### A Regular Section of Land 1 Mile = 5,280 Ft.

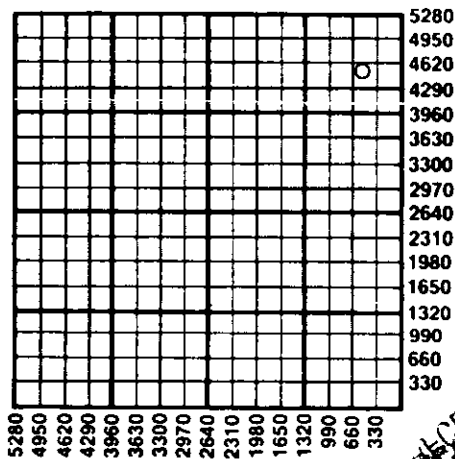

RECEIVED  
STATE CORPORATION COMMISSION  
-ATL-  
NOV 18 1988  
CONSERVATION DIVISION  
Wichita, Kansas

State Corporation Commission of Kansas  
Conservation Division  
200 Colorado Derby Building  
Wichita, Kansas 67202-1212  
(316) 263-3238