

CARD MUST BE TYPED

State of Kansas
NOTICE OF INTENTION TO DRILL

(see rules on reverse side)

COLLECTION
CARD MUST BE SIGNED

52125

Starting Date: 5 20 85
month day year

API Number 15- 007-22,038 -0000

OPERATOR: License # 4285

*

SE. ... SW. SW. Sec 32 . Twp 30 . S, Rge 14. . East
(location) West

Name .. Craig/Stephenson Corporation

Address Box 2646

City/State/Zip ... Ponca City, OK 74602

Contact Person .. Jeff Wolfe

Phone 405-762-9062

* 330 Ft North from Southeast Corner of Section
4290 Ft West from Southeast Corner of Section
(Note: Locate well on Section Plat on reverse side)

CONTRACTOR: License # 5380

Name .. Eagle Drilling, Inc.

City/State Wichita, KS

Nearest lease or unit boundary line 330 feet.
County ... Barber

Lease Name Bibb Well# 1

Domestic well within 330 feet : yes no

Municipal well within one mile : yes no

Well Drilled For: Well Class: Type Equipment:

Oil Swd Infield Mud Rotary

Gas Inj Pool Ext. Air Rotary

OWWO Expl Wildcat Cable

Depth to Bottom of fresh water 150 feet

Lowest usable water formation Permian

Depth to Bottom of usable water 200 feet

Surface pipe by Alternate : 1 2

Surface pipe to be set 250 feet

Conductor pipe if any required None feet

Ground surface elevation 1714 feet MSL

This Authorization Expires 11-2-85

Approved By 5-2-85

If OWWO: old well info as follows:

Operator

Well Name

Comp Date Old Total Depth

Projected Total Depth 4000 feet

Projected Formation at TD ... Lansing

Expected Producing Formations Douglas

* was. SW SW SE
2310 FEL

Date Signature of Operator or Agent


Robert L. Eisel
Robert L. Eisel, Agent

Title

RECEIVED
STATE CORPORATION COMMISSION

Must be filed with the K.C.C. five (5) days prior to commencing well
This card void if drilling not started within six (6) months of date received by K.C.C.

MAY 21 1985
5-21-85
CONSERVATION DIVISION
A Regular Section of Land
Wichita, Kansas
1 Mile = 5,280 Ft.

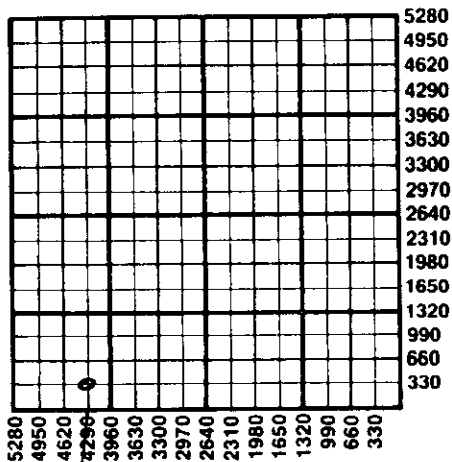

Important procedures to follow :

1. Notify District office before setting surface casing.
2. Set surface casing by circulating cement to the top.
3. File completion forms ACO-1 with K.C.C. within 90 days of well completion, following instructions on ACO-1, side 1, and including copies of wireline logs.
4. Notify District office 48 hours prior to old well workover or re-entry.
5. Prior to plugging, prepare a plugging plan, then obtain agreement from the appropriate district office for an approved plugging plan.
6. Submit plugging report (CP-4) to K.C.C. after plugging is completed.
7. Obtain an approved injection docket number before disposing of salt water.
8. Notify K.C.C. within 10 days when injection commences or terminates.
9. If an alternate 2 completion, cement in the production pipe from below any usable water to surface within 120 days of spud date.

State Corporation Commission of Kansas
Conservation Division
200 Colorado Derby Building
Wichita, Kansas 67202
(316) 263-3238