

CARD MUST BE TYPED

State of Kansas

CARD MUST BE SIGNED

NOTICE OF INTENTION TO DRILL

October 14, 1987 (see rules on reverse side)

Expected Spud Date..... month day year

API Number 15— 165-21,389-0000

DRY

OPERATOR: License # 6331 & 5146

E/2 NE NE Sec. 31 Twp. 19 S. Rg. 19 East West

Name Taurexco, Inc. & Rains & Williamson Oil Co.

4620 Ft. from South Line of Section

Address 125 N. Market, Suite 1210

330 Ft. from East Line of Section

City/State/Zip Wichita, KS 67202

(Note: Locate well on Section Plat on reverse side)

Contact Person Thomas C. Hyde

Nearest lease or unit boundary line 330 feet

Phone 316-262-8339

County Rush

CONTRACTOR: License # 5146

Lease Name - Maresch Well # 1

Name Rains & Williamson Oil Co., Inc.

Ground surface elevation feet MSL

City/State Wichita, KS

Domestic well within 330 feet: ___yes no

Well Drilled For: Well Class: Type Equipment:

Municipal well within one mile: ___yes no

Oil ___ Storage ___ Infield Mud Rotary

Depth to bottom of fresh water 50

___ Gas ___ Inj ___ Pool Ext. ___ Air Rotary

Depth to bottom of usable water 450

___ OWWO ___ Expl Wildcat ___ Cable

Surface pipe by Alternate: 1 2 ___

If OWWO: old well info as follows:

Surface pipe planned to be set 480 520

Operator

Conductor pipe required

Well Name

Projected Total Depth 4300 feet

Comp Date Old Total Depth.....

Formation Cherokee

I certify that well will comply with K.S.A. 55-101, et seq., plus eventually plugging hole to KCC specifications.

Date 10/07/87 Signature of Operator or Agent Thomas C. Hyde Title President

For KCC Use:

Conductor Pipe Required feet; Minimum Surface Pipe Required 480 feet per Alt. 10


This Authorization Expires 4-7-88 Effective 10-12-87 Approved By 10-7-87

Must be filed with the K.C.C. five (5) days prior to commencing well
This card void if drilling not started within six (6) months of date received by K.C.C.

Important procedures to follow:

1. Notify District office before setting surface casing.
2. Set surface casing by circulating cement to the top.
3. File completion forms ACO-1 with K.C.C. within 120 days of well spud date, following instructions on ACO-1, side 1, and including copies of wireline logs.
4. Notify District office 48 hours prior to old well workover or re-entry.
5. Prior to filing Intent, prepare a proposed plugging plan in case well is D & A, then obtain approval of plan when calling district office prior to setting surface pipe.
6. Submit plugging report (CP-4) to K.C.C. after plugging is completed.
7. Obtain an approved injection docket number before disposing of salt water.
8. Notify K.C.C. within 10 days when injection commences or terminates.
9. If an alternate 2 completion, cement in the production pipe from below any usable water to surface within 120 days of spud date.

A Regular Section of Land 1 Mile = 5,280 Ft.

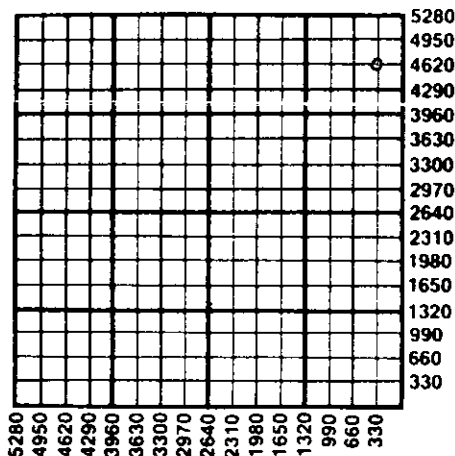

Reid
10-7-87

State Corporation Commission of Kansas
Conservation Division
200 Colorado Derby Building
Wichita, Kansas 67202-1212
(316) 263-3238