

CARD MUST BE TYPED

State of Kansas
NOTICE OF INTENTION TO DRILL
(see rules on reverse side)

CARD MUST BE SIGNED

Starting Date: 10/10/85
month day year

API Number 15- 007-22,088-00-00

OPERATOR: License # KCC#4538
Name BOSWELL ENERGY CORPORATION
Address 6600 N. Harvey, Suite 100
City/State/Zip Oklahoma City, OK 73116
Contact Person R. Kent Pinson
Phone 405-840-4073

C NE/4. SW/4 SE/4 Sec 14. Twp 33S S, Rge 11W East West
(location)
..... 990 Ft North from Southeast Corner of Section
..... 1650 Ft West from Southeast Corner of Section
(Note: Locate well on Section Plat on reverse side)

CONTRACTOR: License #
Name UNKNOWN
City/State

Nearest lease or unit boundary line 990 feet.
County Barber
Lease Name Circle Well# 1-14
Domestic well within 330 feet: yes no
Municipal well within one mile: yes no

Well Drilled For: Well Class: Type Equipment:
 Oil Swd Infield Mud Rotary
 Gas Inj Pool Ext. Air Rotary
 OWWO Expl Wildcat Cable

Depth to Bottom of fresh water 50 feet
Lowest usable water formation Whitehorse
Depth to Bottom of usable water 200 feet
Surface pipe by Alternate: 1 2
Surface pipe to be set 250-300 feet
Conductor pipe if any required None feet
Ground surface elevation 1,485 feet MSL
This Authorization Expires 3-30-86
Approved By 9-30-85 *R* KCH/KDHC

If OWWO: old well info as follows:
Operator
Well Name
Comp Date Old Total Depth
Projected Total Depth 4,700 feet
Projected Formation at TD Mississippi
Expected Producing Formations Mississippi

I certify that we will comply with K.S.A. 55-101, et seq., plus eventually plugging hole to K.C.C. specifications.


Date 9/26/85 Signature of Operator or Agent *R Kent Pinson* Title Land Manager

Must be filed with the K.C.C. five (5) days prior to commencing well
This card void if drilling not started within six (6) months of date received by K.C.C.

Important procedures to follow:

A Regular Section of Land
1 Mile = 5,280 Ft.

1. Notify District office before setting surface casing.
2. Set surface casing by circulating cement to the top.
3. File completion forms ACO-1 with K.C.C. within 90 days of well completion, following instructions on ACO-1, side 1, and including copies of wireline logs.
4. Notify District office 48 hours prior to old well workover or re-entry.
5. Prior to plugging, prepare a plugging plan, then obtain agreement from the appropriate district office for an approved plugging plan.
6. Submit plugging report (CP-4) to K.C.C. after plugging is completed.
7. Obtain an approved injection docket number before disposing of salt water.
8. Notify K.C.C. within 10 days when injection commences or terminates.
9. If an alternate 2 completion, cement in the production pipe from below any usable water to surface within 120 days of spud date.

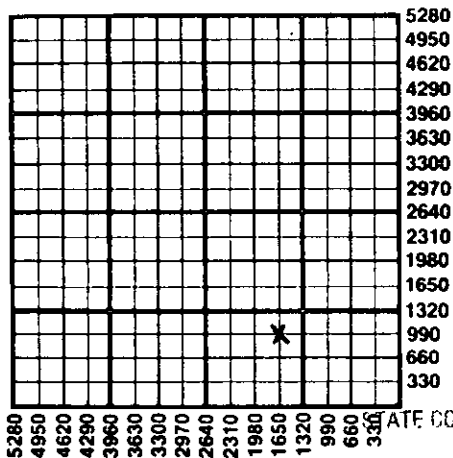

RECEIVED
STATE CORPORATION COMMISSION

SEP 30 1935

CONSERVATION DIVISION
Wichita, Kansas

State Corporation Commission of Kansas
Conservation Division
200 Colorado Derby Building
Wichita, Kansas 67202
(316) 263-3238