

CARD MUST BE TYPED

State of Kansas

CARD MUST BE SIGNED

# NOTICE OF INTENTION TO DRILL

(see rules on reverse side)

10403-00-01

Starting Date ..... 5 ..... 1 ..... 87 .....  
month day year

API Number 15- 007-01-018

OPERATOR: License # ..... 9533 .....  
Name Fairchild Exploration Inc.  
Address RR3  
City/State/Zip Kingman, Kansas 67068  
Contact Person Bob Fairchild  
Phone 316 532-3047

..... G. SW. SW. Sec. 26. Twp. 30. S, Rg. 14. X East  
..... 660 ..... Ft. from South Line of Section  
..... 4620 ..... Ft. from East Line of Section

(Note: Locate well on Section Plat on reverse side)

CONTRACTOR: License # ..... 5429 .....  
Name Hayes Well Service  
City/State Attica, Kansas 67009

Nearest lease or unit boundary line ..... 660 ..... feet  
County Barber  
Lease Name Lambert Well # 1  
Ground surface elevation ..... 1839 ..... feet MSL  
Domestic well within 330 feet: \_\_\_\_\_ yes X no  
Municipal well within one mile: \_\_\_\_\_ yes X no

Well Drilled For: Well Class: Type Equipment:  
X Oil — SWD — Infield — Mud Rotary  
— Gas — Inj X Pool Ext. — Air Rotary  
X OWWO X Expl — Wildcat — Cable

Depth to bottom of fresh water .....  
Depth to bottom of usable water ..... 200 .....  
Surface pipe by Alternate: 1A 2 —  
Surface pipe placed to set ..... 275 .....  
Conductor pipe required .....  
Projected Total Depth ..... 4000 ..... feet  
Formation Douglas Sand

If OWWO: old well info as follows:

Operator Thunderbird Drilling Inc.,  
Well Name Lambert #1  
Comp Date 12-23-64. Old Total Depth 4766

I certify that well will comply with K.S.A. 55-101, et seq., plus eventually plugging hole to KCC specifications.

Date 4-23-87. Signature of Operator or Agent Timothy G. Pierce Title Agent

For KCC Use:

Conductor Pipe Required ..... feet; Minimum Surface Pipe Required ..... 275 ..... feet per Alt. 1  
This Authorization Expires 10-23-87 Approved By 4-23-87


*Timothy G. Pierce*

Must be filed with the K.C.C. five (5) days prior to commencing well  
This card void if drilling not started within six (6) months of date received by K.C.C.

**Important procedures to follow:**

1. Notify District office before setting surface casing.
2. Set surface casing by circulating cement to the top.
3. File completion forms ACO-1 with K.C.C. within 90 days of well completion, following instructions on ACO-1, side 1, and including copies of wireline logs.
4. Notify District office 48 hours prior to old well workover or re-entry.
5. Prior to filing Intent, prepare a proposed plugging plan in case well is D & A, then obtain approval of plan when calling district office prior to setting surface pipe.
6. Submit plugging report (CP-4) to K.C.C. after plugging is completed.
7. Obtain an approved injection docket number before disposing of salt water.
8. Notify K.C.C. within 10 days when injection commences or terminates.

**A Regular Section of Land  
1 Mile = 5,280 Ft.**

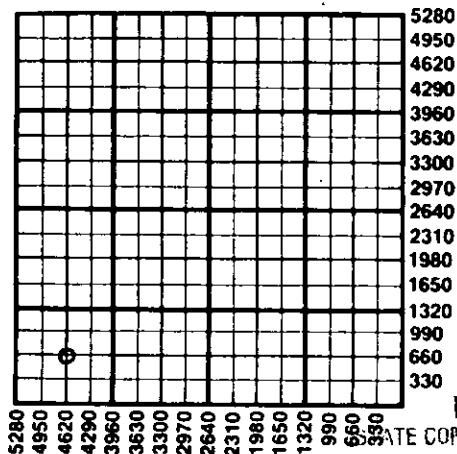

RECEIVED

STATE CORPORATION COMMISSION

APR 23 1987  
4-23-87  
CONSERVATION DIVISION  
Wichita, Kansas

If an alternate 2 completion, cement in the production pipe from below any usable water to surface within 120 days of spud date.

State Corporation Commission of Kansas  
Conservation Division  
200 Colorado Derby Building  
Wichita, Kansas 67202  
(316) 263-3238