

STATE CORPORATION COMMISSION OF KANSAS
OIL & GAS CONSERVATION DIVISION
WELL COMPLETION OR RECOMPLETION FORM
ACO-1 WELL HISTORY
DESCRIPTION OF WELL AND LEASE

Operator: License # 03532
Name CMX, Inc.
Address 1026 Union Center Building
City/State/Zip Wichita, Kansas 67202

Purchaser N/A

Operator Contact Person Doug McGinness II
Phone 316-269-9052

Contractor: License # 5302
Name Red Tiger Drilling Company

Wellsite Geologist Monte Marrs & Doug McGinness II
Phone (316)262-8339 & (316)269-9052

Designate Type of Completion
 New Well Re-Entry Workover
 Oil SWD Temp Abd
 Gas Inj Delayed Comp.
 Dry Other (Core, Water Supply etc.)

If ONWO: old well info as follows:
Operator
Well Name
Comp. Date Old Total Depth

WELL HISTORY

Drilling Method:
 Mud Rotary Air Rotary Cable
4/4/88 4/11/88 4/12/88
Spud Date Date Reached TD Completion Date
4,330'
Total Depth PBTD
Amount of Surface Pipe Set and Cemented at 220 feet
Multiple Stage Cementing Collar Used? Yes No
If yes, show depth set feet
If alternate 2 completion, cement circulated from feet depth to w/ SX cmt
Cement Company Name
Invoice #
AIR II Dry

API NO. 15-165-21,410-0000
County Rush
150' North of East
E/2.NE/4.SW/4. Sec.31. Twp.19S. Rge.19W. X West

2130 Ft North from Southeast Corner of Section
2970 Ft West from Southeast Corner of Section
(Note: Locate well in section plat below)


Lease Name Price Well # 1-31

Field Name Wildcat

Producing Formation N/A

Elevation: Ground 2254' KB 2259'

Section Plat

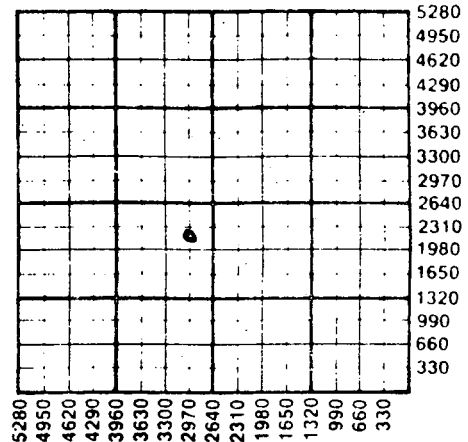

WATER SUPPLY INFORMATION

Disposition of Produced Water: Disposal
Docket # Repressuring

Questions on this portion of the ACO-1 call:
Water Resources Board (913) 296-3717

Source of Water:
Division of Water Resources Permit #
 Groundwater Ft North from Southeast Corner (Well) Ft West from Southeast Corner of Sec Twp Rge East West
 Surface Water 2400 Ft North from Southeast Corner (Stream, pond etc) 1100 Ft West from Southeast Corner Sec 12 Twp 19S Rge 20 East X West
Oliver Williams, LaCrosse, Ks. 67548
Other (explain)
(purchased from city, R.W.D. #)

INSTRUCTIONS: This form shall be completed in triplicate and filed with the Kansas Corporation Commission, 200 Colorado Derby Building, Wichita, Kansas 67202, within 120 days of the spud date of any well. Rule 82-3-130, 82-3-107 and 82-3-106 apply. Information on side two of this form will be held confidential for a period of 12 months if requested in writing and submitted with the form. See rule 82-3-107 for confidentiality in excess of 12 months. One copy of all wireline logs and drillers time log shall be attached with this form. Submit CP-4 form with all plugged wells. Submit CP-111 form with all temporarily abandoned wells.

All requirements of the statutes, rules and regulations promulgated to regulate the oil and gas industry have been fully complied with and the statements herein are complete and correct to the best of my knowledge.

Signature [Signature] Title President Date 05-06-88

Subscribed and sworn to before me this 6th day of May 1988...
Notary Public De Ann Renee Konkell
Date Commission Expires April 8, 1989

DE ANN RENEE KONKEL
NOTARY PUBLIC
STATE OF KANSAS
My Appt. Exp. 4-8-89

K.C.C. OFFICE USE ONLY
Letter of Confidentiality Attached
Wireline Log Received
Drillers Timelog Received
Distribution
RECEIVED
RECEIVED
Form ACO-1 (5-86)
Wichita, Kansas
Sec. 31 Twp. 19 Rge. 19 W

CONSERVATION DIVISION
Wichita, Kansas