


WELL PLUGGING RECORD

Use All-Information Completely
Make Required Affidavit
Mail or Deliver Report to:
Conservation Division
State Corporation Commission
800 Bitting Building
Wichita, Kansas

Barber County, Sec. 1 Twp. 33S Rge. (E) 15 (W)
Location as "NE/CNW/SW" or footage from lines C - NW/4 NW/4 NW/4
Lease Owner Lion Oil Company
Lease Name Lile Well No. 1
Office Address P. O. Box 639, Pratt, Kansas
Character of Well (completed as Oil, Gas or Dry Hole) Gas
Date well completed 2- 3- 1952
Application for plugging filed 5-21 1954
Application for plugging approved 5-24 1954
Plugging commenced 6- 6 1954
Plugging completed 6- 8 1954
Reason for abandonment of well or producing formation Well started making water.

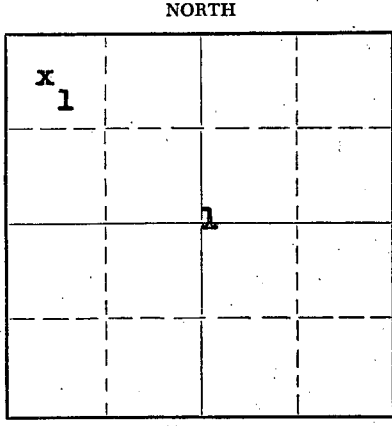

Locate well correctly on above Section Plat

If a producing well is abandoned, date of last production November 15 1953
Was permission obtained from the Conservation Division or its agents before plugging was commenced? Yes

Name of Conservation Agent who supervised plugging of this well Merle A. Rives
Producing formation Mississippi Depth to top 4873 Bottom 4973 Total Depth of Well 5427 Feet
Show depth and thickness of all water, oil and gas formations. Plugged Back T. D. 4300 "

OIL, GAS OR WATER RECORDS

CASING RECORD

FORMATION	CONTENT	FROM	TO	SIZE	PUT IN	PULLED OUT
				8-5/8"	490'	None
				5-1/2"	4973'	3499'

Describe in detail the manner in which the well was plugged, indicating where the mud fluid was placed and the method or methods used in introducing it into the hole. If cement or other plugs were used, state the character of same and depth placed, from _____ feet to _____ feet for each plug set.

Hole plugged back from original total depth of 5427' to 4300' and casing perforated from 4272' to 4280'. Filled hole with sand from 4300' to 4260' and ran 5 sacks of cement. Set a rock bridge from 480' to 450' and ran 20 sacks of cement. Mudded hole to 40', set a 10' rock bridge, and ran 10 sacks of cement on top. Plugging completed.

(If additional description is necessary, use BACK of this sheet)

Name of Plugging Contractor West Supply Company, Inc.
Address Chase, Kansas

STATE OF KANSAS COUNTY OF PRATT SS. Joe Costello (employee of owner) / owner / of the above-described well, being first duly sworn on oath, says: That I have knowledge of the facts, statements, and matters herein contained and the log of the above-described well as filed and that the same are true and correct. So help me God.

(Signature) Joe Costello
P. O. Box 639, Pratt, Kansas
(Address)

SUBSCRIBED AND SWORN TO before me this 16th day of June, 19 54

My commission expires August 29, 1955

Van Sauber
Notary Public.

PLUGGING
FILE SEC L 33 R 15W
BOOK PAGE 36 LINE 12

RECEIVED
STATE CORPORATION COMMISSION
JUN 17 1954
CONSERVATION DIVISION
Wichita, Kansas

File No. 1

NW NW NW
Sec. 1-33S-15W
Barber County, Kansas

Lease Owner: Lion Oil Company

Contractor: R. C. Patton Drilling Company
Date Started: 12-27-51

Date Finished: 2-3-52

LOG

Sub-Soil Sand	0 - 30	
Sandy Clay and Sand	30 - 125	
Red Bed and Shells	125 - 265	Straight hole test @ 158' - OK
Red Bed and Shells	265 - 491	8-5/8" @ 490' w/300 sacks
Red Bed and Shale	491 - 770	Straight hole test @ 450' - OK
Red Bed, Shale & Shells	770 - 1115	Straight hole test @ 1000' - OK
Shale and Shells	1115 - 1875	Straight hole test @ 1650' - OK
Shale and Shells	1875 - 2105	Straight hole test @ 2075' - OK
Shale and Lime	2105 - 2265	
Lime	2265 - 2335	
Lime	2335 - 2395	
Lime	2395 - 2495	
Lime and Shale	2495 - 2585	
Lime	2585 - 2620	
Lime and Shale	2620 - 2675	
Lime and Shale	2675 - 2760	Straight hole test @ 2750' - OK
Lime and Shale	2760 - 2830	
Shale and Lime	2830 - 2895	
Lime and Shale	2895 - 2980	
Shale and Lime	2980 - 3075	
Shale and Shells	3075 - 3175	
Lime and Shale	3175 - 3295	
Shale and Lime	3295 - 3380	
Lime and Shale	3380 - 3445	
Shale and Lime	3445 - 3500	
Lime and Shale	3500 - 3635	
Lime and Shale	3635 - 3800	Straight hole test @ 3750' - OK
Lime	3800 - 3855	
Lime and Shale	3855 - 3890	
Lime	3890 - 3920	
Lime and Shale	3920 - 3965	
Lime and Shale	3965 - 4020	Straight Hole test @ 4000' - OK
Broken Lime and Shale	4020 - 4095	
Lime and Shale	4095 - 4280	
Lime and Shale	4280 - 4315	
Lime	4315 - 4350	
Lime and Shale	4350 - 4420	
Lime	4420 - 4467	
Lime	4467 - 4575	Straight hole test @ 4500' - OK
Lime	4575 - 4645	
Lime	4645 - 4760	
Lime	4760 - 4785	
Lime and Shale	4785 - 4825	
Lime	4825 - 4855	
Lime and Shale	4855 - 4885	
Lime	4885 - 4907	
Chert and Lime	4907 - 4925	
Lime and Shale	4925 - 4955	
Shale	4955 - 4980	
Shale and Lime	4980 - 5040	
Shale	5040 - 5085	
Shale and Lime	5085 - 5165	
Lime	5165 - 5214	
Lime	5214 - 5288	
Shale and Lime	5288 - 5302	
Lime	5302 - 5303	
Sand	5303 - 5350	
Sand and Lime	5350 - 5382	
Lime	5408 - 5427	R. T. D. 5-1/2" @ 4973' w/250 sacks

PLUGGING
 NW 33-15W
 PAGE 36 LINE 12

RECEIVED
 CORPORATION COMMISSION
 MAY 24 1954
 CONSERVATION DIVISION
 Topeka, Kansas

STATE OF KANSAS) ss.
COUNTY OF PRATT)

I, Vernon Hayes, do hereby certify that the above is a true and accurate log of the
Lile Well No. 1, located NW NW NW Sec. 1-33S-15W, Barber County, Kansas

Vernon Hayes
 Superintendent
Don Seibel