

15-007-20888-00-00


STATE OF KANSAS
STATE CORPORATION COMMISSION

WELL PLUGGING RECORD

Give All Information Completely
Make Required Affidavit
Mail or Deliver Report to
Conservation Division
State Corporation Comm.
245 North Water
Wichita, KS 67202

Barber County, Sec. 6 Twp. 33S Rge. 15W E/W
Location as "NE/CNW $\frac{1}{4}$ SW $\frac{1}{4}$ " or footage from lines 660' from the
Northeast line & 660' from the Center of the section

Lease Owner Murjo Oil & Royalty Co.
Lease Name Brass Well No. 1
Office Address 2525 Ridgmar Blvd., Fort Worth, Tx. 76116
Character of Well (Completed as Oil, Gas or Dry Hole) Dry Hole

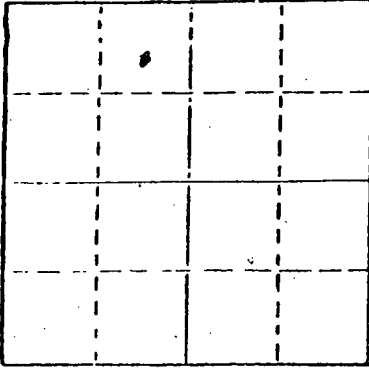

Locate well correctly on above
Section Plot

Date Well completed 2-28-1980
Application for plugging filed 2-28-1980
Application for plugging approved 2-28-1980
Plugging commenced 2-28-1980
Plugging completed 2-28-1980
Reason for abandonment of well or producing formation Dry Hole

If a producing well is abandoned, date of last production 19

Was permission obtained from the Conservation Division or
its agents before plugging was commenced? Yes

Name of Conservation Agent who supervised plugging of this well Bill Owens
Producing formation _____ Depth to top _____ Bottom _____ Total Depth of Well _____
Show depth and thickness of all water, oil and gas formations.

OIL, GAS OR WATER RECORDS

CASING RECORD

FORMATION	CONTENT	FROM	TO	SIZE	PUT IN	PULLED OUT
		0	279'	8 5/8"	6 jts.	

Describe in detail the manner in which the well was plugged, indicating where the mud fluid
was placed and the method or methods used in introducing it into the hold. If cement or other
plugs were used, state the character of same and depth placed, from _____ feet to
_____ feet for each plug set. 250' with 40 sacks cement, mud to 40' with 10 sacks cement,
cement, 5 sack cement in rat hole.

(If additional description is necessary, use BACK of this sheet)

Name of Plugging Contractor Halliburton

STATE OF Kansas COUNTY OF Sedgwick, ss.
(employee of owner) or (owner or operator)
of the above-described well, being first duly sworn on oath, says: That I have knowledge of
the facts, statements, and matters herein contained and the log of the above-described well
as filed and that the same are true and correct. So help me God.

(Signature)

Kirby G. Evers

P.O. Box 13611, Wichita, Kansas 67217

(Address)

SUBSCRIBED AND SWORN TO before me this 3rd day of March, 19 80

Mary Kay Collins
Notary Public.

My commission expires MY APPOINTMENT EXPIRES NOV 28, 1980

RECEIVED
STATE CORPORATION COMMISSION
MAR - 5 1980
CONSERVATION DIVISION
Wichita, Kansas

WELL LOG

OPERATOR: MURJO OIL & ROYALTY COMPANY
CONTRACTOR: XPLOR DRILLING COMPANY

COMMENCED: 2-18-80
COMPLETED: 2-18-80
CASING RECORD: 8 5/8" @ 279'

<u>FORMATION</u>	<u>FROM</u>	<u>TO</u>
Red Bed	0	2185'
Lime & Shale	2185'	4750'

STATE OF KANSAS)
) SS:
COUNTY OF SEDGWICK)

I certify that this is a true and correct copy of the Driller's Log on the well drilled NE/4 NE/4, Sec. 6-33S-15W, Barber County Kansas to the best of my knowledge and belief.

XPLOR DRILLING COMPANY

Kirby C. Evers
Kirby C. Evers, Vice President
RECEIVED
STATE CORPORATION COMMISSION

Subscribed and sworn to before me this third of March, 1980

MAR - 5 1980
CONSERVATION DIVISION
Wichita, Kansas

Mary Kay Oudenz

My appointment expires:

MY APPOINTMENT EXPIRES NOV 28, 1980