

STATE OF KANSAS
STATE CORPORATION COMMISSION

Form CP-4

Give All Information Completely
Make Required Affidavit
Mail or Deliver Report to:
Conservation Division
State Corporation Commission
P. O. Box 17027
Wichita, Kansas 67217
NORTH

WELL PLUGGING RECORD

Barber County, Sec. 7 Twp. 33 Rge. 15 (E) (W) X

Location as "NE/CNW/SW" or footage from lines _____
NE SE NE

Lease Owner: Beren Corporation

Lease Name: Lendon B Well No. #2

Office Address: 1130 Vickers KSB&T Bldg. Wichita, Kansas

Character of Well (completed as Oil, Gas or Dry Hole) _____

Date well completed _____ 19__

Application for plugging filed _____ 19__

Application for plugging approved _____ 19__


Plugging commenced: 5-8-73 _____ 19__

Plugging completed: 5-10-73 _____ 19__

Reason for abandonment of well or producing formation _____

If a producing well is abandoned, date of last production _____ 19__

Was permission obtained from the Conservation Division or its agents before plugging was commenced? _____

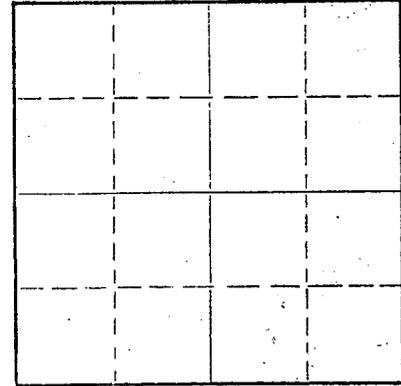

Locate well correctly on above Section Plat

Name of Conservation Agent who supervised plugging of this well: G. R. Biberstein

Producing formation _____ Depth to top _____ Bottom _____ Total Depth of Well _____ Feet

Show depth and thickness of all water, oil and gas formations.

OIL, GAS OR WATER RECORDS

CASING RECORD

FORMATION	CONTENT	FROM	TO	SIZE	PUT IN	PULLED OUT
				5 1/2"	4907'	4040.88'
				13 3/8"	277'	

Describe in detail the manner in which the well was plugged, indicating where the mud fluid was placed and the method or methods used in introducing it into the hole. If cement or other plugs were used, state the character of same and depth placed, from _____ feet to _____ feet for each plug set.

Made bottom hole plug back with sand to 4300'. Mixed and ran 5 sacks cement thru dump bailer.

Mudded hole to 200' - set 20' rock bridge. Filled hole with 8 yards ready-mix from 180' to base of cellar.

RECEIVED
STATE CORPORATION COMMISSION

MAY 14 1973

CONSERVATION DIVISION
Wichita, Kansas

(If additional description is necessary, use BACK of this sheet)
Name of Plugging Contractor: Southwest Casing Pulling Co.
Address: Box 364 Great Bend, Kansas

STATE OF Kansas, COUNTY OF Barton, ss.
Southwest Casing Pulling Co. (employee of owner) or (owner or operator) of the above-described well, being first duly sworn on oath, says: That I have knowledge of the facts, statements, and matters herein contained and the log of the above-described well as filed and that the same are true and correct. So help me God.


(Signature) W. C. Spencer Sec.

Box 364 Great Bend, Kansas
(Address)

SUBSCRIBED AND SWORN to before me this 11 day of May, 19 73

Sidney D. Miller
Notary Public.

My commission expires 24 October 1976

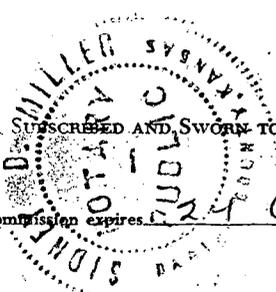

645-05

Sunray DX Oil Company
Tulsa, Oklahoma

Tulsa, Oklahoma
June 30, 1964

Contractor: Stickle Drilling Company
Date Commenced: June 14, 1964
Date Completed: June 25, 1964

Hazel B. Lendon "B" No. 2
NE SE NE Section 7-33S-15W
Barber County, Kansas

DRILLER'S LOG

Depth Figures Indicate Base of Formation:

Red bed	41
Shale and red bed	1050
Shale and shells	1425
Shale and lime	2643
Lime and shale	2972
Shale and chalky lime	3775
Shale, chalk and lime	4000
Shale and lime	4080
Lime	4200
Cherty lime	4226
Lime	4732
Cherty lime	4784
Lime	4823
Lime and sand	4843
Lime	4910 TD

RECEIVED
STATE CORPORATION COMMISSION
MAY 1 1973
CONSERVATION DIVISION
Wichita, Kansas

I, Fred E. Stickle, hereby certify the above to be a true and complete Driller's Log of Sunray DX Oil Company's Hazel B. Lendon "B" No. 2, NE SE NE OF Section 7-33S-15W, Barber County, Kansas.

Fred E. Stickle
FRED E. STICKLE

M. W. Mearley
Notary Public

My Commission Expires January 11, 1967