


WELL PLUGGING RECORD

Give All Information Completely
Make Required Affidavit
Mail or Deliver Report to:
Conservation Division
State Corporation Commission
800 Bitting Building
Wichita, Kansas

NORTH

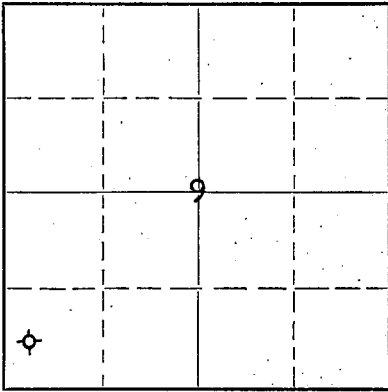

Locate well correctly on above
Section Plat

Barber County, Sec. 9 Twp. 33S Rge. 15W (E) (W)

Location as "NE/CNW¹/₄SW¹/₄" or footage from lines C. W¹/₂ SW SW

Lease Owner Fisher Oil Company

Lease Name Brass Well No. 1

Office Address Clark Building - Pittsburgh, Pennsylvania

Character of Well (completed as Oil, Gas or Dry Hole) Dry hole

Date well completed February 7 19 52

Application for plugging filed February 10 19 52

Application for plugging approved February 11 19 52

Plugging commenced February 7 19 52

Plugging completed February 7 19 52

Reason for abandonment of well or producing formation Dry hole

If a producing well is abandoned, date of last production 19

Was permission obtained from the Conservation Division or its agents before plugging was commenced? yes

Name of Conservation Agent who supervised plugging of this well C. D. Stough

Producing formation Depth to top Bottom Total Depth of Well 5438 Feet

Show depth and thickness of all water, oil and gas formations.

OIL, GAS OR WATER RECORDS

CASING RECORD

Formation	Content	From	To	Size	Put In	Pulled Out

Describe in detail the manner in which the well was plugged, indicating where the mud fluid was placed and the method or methods used in introducing it into the hole. If cement or other plugs were used, state the character of same and depth placed, from feet to

feet for each plug set.

Filled hole to 270' with mud laden fluid.

Cemented with 15 sacks cement.

Filled hole to 35' with mud.

Topplug set at 35' with 10 sacks cement.

Well plugged at 12:30 a.m.

(If additional description is necessary, use BACK of this sheet)

Name of Plugging Contractor W. J. Coppinger

Address 320 Union Nat'l Bank Bldg.

Wichita, Kansas

STATE OF Kansas, COUNTY OF Sedgwick, ss.

W. J. Coppinger (employee of owner) or (owner or operator) of the above-described well,

being first duly sworn on oath, says: That I have knowledge of the facts, statements, and matters herein contained and the log of the above-described well as filed and that the same are true and correct. So help me God.

(Signature) *W. J. Coppinger*

(Address)

SUBSCRIBED AND SWORN TO before me this 14th day of February, 1952

My commission expires April 18, 1955.

Henry S. Ficken
Notary Public.

PLUGGING
FILE SEC 9 T 33 R 20
NO. 143 LINE 29
FEB 15 1952
CONSERVATION DIVISION
Wichita, Kansas

DRILLERS LOG

Fisher Oil Company - Operator
 W. J. Coppinger - Contractor

J. W. BRASS #1
 C W 1/2 SW SW 9-338-15W
 Barber County, Kansas

Casing Record:
 8 5/8" at 747' with 450 sacks cement

Surface Clay	20
Rock	30
Red Bed	340
Red Bed & Shells	715
Anhydrite	751
Shale & Salt	890
Shale & Shells	1850
Broken Lime & Shale	1900
Lime & Shale	2457
Cherty lime & Shale	2515
Lime & Shale	3075
Shale & Broken Lime	3130
Shale & Lime	3160
Shale & Broken Lime	3235
Shale & Lime	3415
Lime	3720
Shale & Lime	3887
Sand	3925
Sand & Shale	3980
Sand, Shale & Shells	4030
Shale & Lime	4035
Shale & Brown Lime	4081
Lime	4085
Shale & Lime	4215
Lime	4248
Lime & Shale	4310
Lime	4413
Lime & Shale	4448
Lime	4594
Lime & Shale	4630
Lime	4698
Shale & Lime	4855
Sand	4859
Lime	4869
Shale & Lime	4979
Shale & Cherty Lime	5009
Shale & Lime	5090
Cherty Lime	5095
Shale & Lime	5130
Kinderhook Shale	5155
Lime, Chert & Shale	5180
Lime & Chert	5219
Lime & Shale	5237
Cherty Lime	5261
Lime	5285
Simpson	5325
Hard Sand	5335
Sand and Shale	5352
Lime, Sand & Shale	5370
Shale & Sand	5397
Lime & Shale	5428
Viola	5438

Tops:

T Anhydrite	715'
T Kansas City	4210'
B Kansas City	4690'
T Miss shale	4850'
T Kinderhook	5040'
T Misener sand	5116'
T Viola	5153'
T Simpson	5293'
T Arbuckle	5402'
Total Rotary Depth	5438'
Comm:	1-2-52
Comp:	2-7-52
Elevation:	1848' R. B.
	1845' D.F.

DRY AND ABANDONED

STATE OF KANSAS:

COUNTY OF SEDGWICK: ss

I, the undersigned, being duly sworn, on oath state that the above statement and log is a true and correct record and log of the well drilled at the location above described.

PLUGGING
 FILED SEC 9 T 33 R 15W
 BOOK PAGE 143 LINE 29

Subscribed and sworn to before me this 17th day of February, 1952.

W. J. Coppinger
 W. J. Coppinger

Henry D. Fischer
 Notary Public