

STATE OF KANSAS
STATE CORPORATION COMMISSION

WELL PLUGGING RECORD

Give All Information Completely
Make Required Affidavit
Mail or Deliver Report to:
Conservation Division
State Corporation Commission
211 No. Broadway
Wichita, Kansas

Barber

County. Sec. 9 Twp. 33S Rge. (E) 15 (W)

Location as "NE/CNW/SW" or footage from lines CW/2SW SW

Lease Owner Wm. R. Wood, Jr.

Lease Name Brass

Well No. 1

Office Address 4129 South Peoria, Tulsa, Oklahoma

Character of Well (completed as Oil, Gas or Dry Hole) Dry Hole (OWWO)

Date well completed October 24, 1956 19

Application for plugging filed October 24, 1956 19

Application for plugging approved October 24, 1956 19


Plugging commenced October 24, 1956 19

Plugging completed October 30, 1956 19

Reason for abandonment of well or producing formation Old rotary hole washed down dry and abandoned

If a producing well is abandoned, date of last production none 19

Was permission obtained from the Conservation Division or its agents before plugging was commenced? Yes

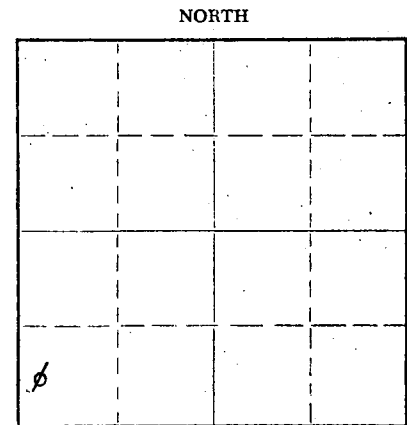

Locate well correctly on above Section Plat

Name of Conservation Agent who supervised plugging of this well M. A. Rives

Producing formation _____ Depth to top _____ Bottom _____ Total Depth of Well 5428 Feet

Show depth and thickness of all water, oil and gas formations.

OIL, GAS OR WATER RECORDS

CASING RECORD

FORMATION	CONTENT	FROM	TO	SIZE	PUT IN	PULLED OUT
				8-5/8"	747'	
				5-1/2"	5240'	3843'

Describe in detail the manner in which the well was plugged, indicating where the mud fluid was placed and the method or methods used in introducing it into the hole. If cement or other plugs were used, state the character of same and depth placed, from _____ feet to _____ feet for each plug set.

Measured into T.D. 5428'
Plugging started 10-24-56. Finished 10-30-56.
Plugged off bottom with sand to 4815 feet and dumped 5 sacks cement with bailer. shot 5 1/2" casing at 3843 feet. Pulled pipe out of hole and plugged well with heavy mud to 300 feet and set permanent rock bridge. Dumped 20 sacks cement, filled hole with heavy mud to 35 feet and set permanent rock bridge and mixed 10 sacks cement for cap on well.

(If additional description is necessary, use BACK of this sheet)
Name of Plugging Contractor J. O. Forbes, d/b/a Forbes Casing Pulling Co.
Address Box 221, Great Bend, Kansas

STATE OF OKLAHOMA, COUNTY OF TULSA, ss.

C.P. Taylor (employee of owner) or (owner or operator) of the above-described well, being first duly sworn on oath, says: That I have knowledge of the facts, statements, and matters herein contained and the log of the above-described well as filed and that the same are true and correct. So help me God.

(Signature) C. P. Taylor
4129 S. Peoria Tulsa 5, Okla.
(Address)

SUBSCRIBED AND SWORN to before me this 26 th day of November, 1956

My commission expires December 4, 1957

Mary E. White
Notary Public.

RECEIVED
STATE CORPORATION COMMISSION

NOV 27 1956

CONSERVATION DIVISION
Wichita, Kansas

PLUGGING
FILE SEC 9 T. 33 R. 15W
BOOK PAGE 109 LINE 36