


15-007-00610-00-00

WELL PLUGGING RECORD

Give All Information Completely
Make Required Affidavit
Mail or Deliver Report to:
Conservation Division
State Corporation Commission
211 No. Broadway
Wichita, Kansas

NORTH

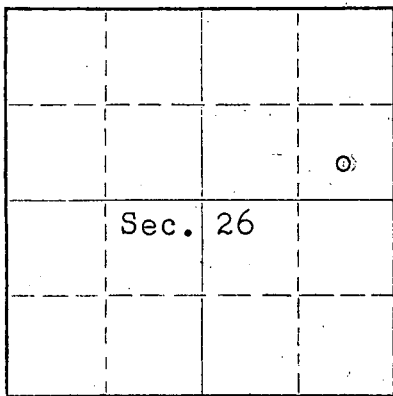

Locate well correctly on above
Section Plat

BARBER County. Sec. 26 Twp. 33 Rge. 10 ~~W~~ W (W)
Location as "NE/CNW/SE/SW" or footage from lines C SE NE
Lease Owner PETROLEUM, INC.
Lease Name EARLY BB" Well No. 1
Office Address ROUTE 2, GREAT BEND, KANSAS
Character of Well (completed as Oil, Gas or Dry Hole) DRY HOLE
Date well completed January 7, 19 58
Application for plugging filed January 8, 19 58
Application for plugging approved January 9, 19 58
Plugging commenced January 7, 19 58
Plugging completed January 7, 19 58
Reason for abandonment of well or producing formation
No Producing Zones

If a producing well is abandoned, date of last production None 19
Was permission obtained from the Conservation Division or its agents before plugging was commenced? Yes

Name of Conservation Agent who supervised plugging of this well M.A. Rives, Box 8, Pratt, Kansas
Producing formation ----- Depth to top --- Bottom --- Total Depth of Well 4620 Feet
Show depth and thickness of all water, oil and gas formations.

OIL, GAS OR WATER RECORDS

CASING RECORD

FORMATION	CONTENT	FROM	TO	SIZE	PUT IN	PULLED OUT
				8-5/8"	258'	None

Describe in detail the manner in which the well was plugged, indicating where the mud fluid was placed and the method or methods used in introducing it into the hole. If cement or other plugs were used, state the character of same and depth placed, from feet to feet for each plug set.

Mud up with heavy mud to 240' followed by wooden plug at 240', placed 20 sacks cement through drill pipe on to plug. Mud up to 35' followed by wooden plug at 35' and 10 sacks cement to base of well cellar.

RECEIVED
STATE CORPORATION COMMISSION

JAN 17 1958

CONSERVATION DIVISION
Wichita, Kansas

01-17-1958

(If additional description is necessary, use BACK of this sheet)

Name of Plugging Contractor Garvey Drilling Company
Address Route 2, Great Bend, Kansas

STATE OF KANSAS, COUNTY OF BARTON, ss.
Don Searle (employee of owner) or (~~owner or operator~~) of the above-described well, being first duly sworn on oath, says: That I have knowledge of the facts, statements, and matters herein contained and the log of the above-described well as filed and that the same are true and correct. So help me God.

(Signature) Don Searle
Route 2, Great Bend, Kansas (Address)

SUBSCRIBED AND SWORN TO before me this 16th day of January, 19 58

My commission expires July 11, 1960 Jed J. Brown Notary Public.

PLUGGING
FILE SEC 26 T 33 R 10 W
BOOK PAGE 74 LINE 36

WELL LOG 15-007-00610-00-00

COMPANY PETROLEUM, INCORPORATED
FARM EARLY "B" NO. 1


SEC. 26 T. 33S R. 10W
LOC. C-SE, NE

TOTAL DEPTH 4620'

COUNTY Barber Co., Kansas

COMM. December 24, 1957 COMP. January 7, 1958

CONTRACTOR GARVEY DRILLING COMPANY

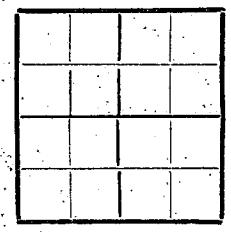

CASING 8 5/8" @ 258, 21' W/200 sax.

ELEVATION 1397' DF

PRODUCTION D & A

FIGURES INDICATE BOTTOM OF FORMATIONS

150	Surface sand & red bed
280	Red bed
1370	Red bed & shale
1690	Shale & shells
1950	Lime & shale
2070	Lime
2565	Shale & lime
3070	Shale*
3700	Lime & shale
3775	Shale
4060	Lime & shale
4310	Lime
4600	Shale & lime
4620	Chert
4620	T. D.

RECEIVED
STATE CORPORATION COMMISSION
JAN 17 1958
CONSERVATION DIVISION
Wichita, Kansas

01-17-1958

PLUGGING
FILE SEC 26 T 33 R 10W
BOOK PAGE 74 LINE 36

State of KANSAS }
County of BARTON } SS:

I, VERNE A. MORRIS of GARVEY DRILLING COMPANY

upon oath state that the above and foregoing is a true and correct copy of the log of the #1 EARLY "B" well

Verne A. Morris

Subscribed and sworn to before me this 15th day of January 19 58

My Commission Expires: November 12, 1958

J. J. Brown
NOTARY PUBLIC